




Surface
Drainage

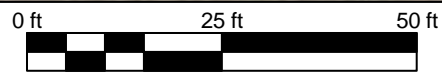

Note: Surface drainage direction is estimated based on site topography and is not related to regional topography.

DRAWN BY: RKI

DATE: 2/9/2016

Facility Diagram
PDC Energy, Inc. – DJ Basin
Rothe 13-29U Wellhead
SWSW S29 T5N R63W
Weld County, CO



6899 Pecos Street, Unit C
Denver, CO 80221

LEGEND

- Excavation Extent
- Release Location
- Soil Sample Location (Trimble GPS)

All locations are approximate unless otherwise noted

FIGURE 2

**SOIL SAMPLE
LOCATION MAP**