


Wellbore Schematic Input Report

Well Name: DESHAZO 24-41

VERTICAL - ORIGINAL HOLE, 2/16/2016 3:00:55 PM

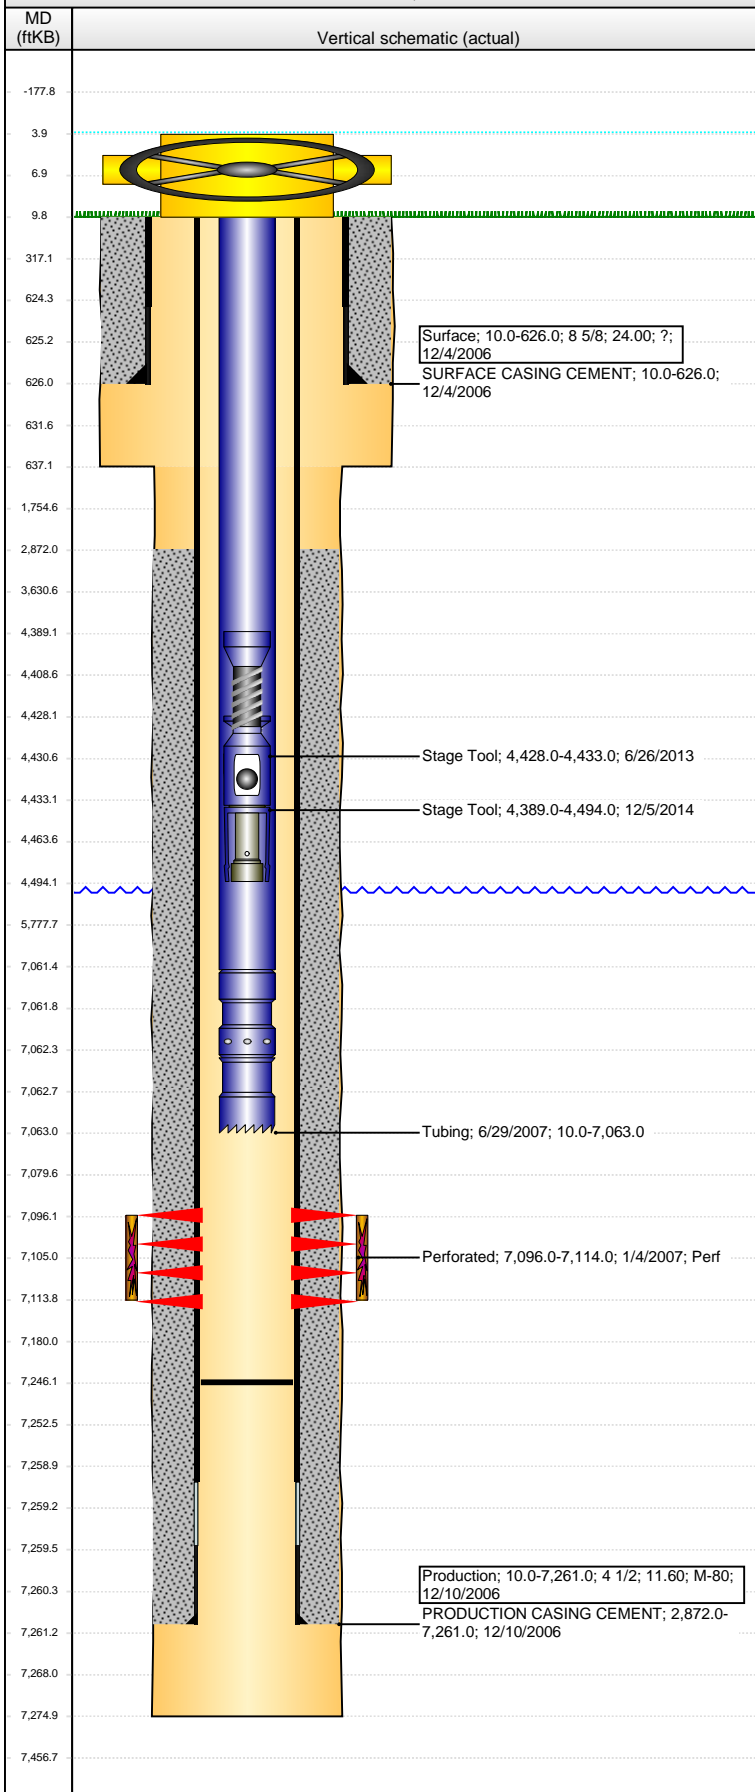

Well Header								
API 05-123-23922		Business Unit DJ BASIN		District 15		Well Config VERTICAL		
Original KB Elevation (ft) 4,761.00		KB - GL / MSL (ftKB) 10.00		Spud Date 12/3/2006		P & A Date		
Comment								
Directions To Well								
Congressional Location								
Quarter 1	Quarter 2 SE	Quarter 3 NE	Quarter 4 SE	Section 24	Township 6 N	Twntshp N...	Range 67	Rng E/W Dir W
Bottom Hole Location								
North-South Distance (ft)		From N or S Line		East-West Distance (ft)			From E or W Line	
Plug Back Total Depths								
Date	Depth (ftKB)	Method			Com			
12/10/2006	7,246.0	CASING TALLY			FLOAT COLLAR ON CASING TALLY			
1/3/2007	7,222.0	CASED HOLE LOG			DEPTH LOGGER ON CBL			
6/29/2007	7,246.0	TAG			CLEAN OUT TO LAND TUBING			
Wellbore Sections								
Section Des			Size (in)		Act Top, MD (ftKB)		Act Btm, MD (ftKB)	
SURFACE			12 1/4		10.0		637.0	
PRODUCTION			7 7/8		637.0		7,275.0	
Zone Statuses								
Zone Name	Status Date	Status	Fluid Type	Job	Prod Method			
CODELL	5/15/2007	PR		DRILLING/CO...				
Casing Strings								
Surface, 626.0ftKB								
Casing Description Surface		Run Date 12/4/2006	OD (in) 8 5/8	Wt/Len (l... 24.00	Grade ?	Top, MD (ft... 10.0	MD (ftKB) 626.0	
Production, 7,261.0ftKB								
Casing Description Production		Run Date 12/10/2006	OD (in) 4 1/2	Wt/Len (l... 11.60	Grade M-80	Top, MD (ft... 10.0	MD (ftKB) 7,261.0	
Cement								
Description SURFACE CASING CEMENT				Top Depth (ftKB) 10.0		Bottom Depth (ftKB) 626.0		
Description PRODUCTION CASING CEMENT				Top Depth (ftKB) 2,872.0		Bottom Depth (ftKB) 7,261.0		
Tubing Strings								
Tubing Description Tubing		Run Date 6/29/2007	String... 2 3/8	ID (in)	Wt (lb/ft)	Grade	Len (ft) 7,053.00	Set De...
Tubing Components								
Item Des		OD (in)	Wt (lb/ft)	Grade	Jts	Len (ft)	Btm (ftKB)	Btm (TVD) (ftKB)
EUE 8rd Tubing		2 3/8			217	7,051.40	7,061.4	
Seal Nipple		2 3/8			1	1.00	7,062.4	
Notched collar		2 3/8			1	0.60	7,063.0	
Perforation Data								
Zone		Bnch/St g	Entered Shot Total	Top (ftKB)		Btm (ftKB)		Date
CODELL, ORIGINAL HOLE			72	7,096.00		7,114.00		1/4/2007
Stimulations & Treatments								
Date 1/5/2007	Zone CODELL, ORIGINAL HOLE			Primary Job Type DRILLING/COMPLETION - ORIGINAL				
Technical Result			Tech Result Details			Tech Result Note		
Comment								
Other In Hole								
Run Date		Des			OD (in)	Top (ftKB)	Btm (ftKB)	
6/26/2013		Stage Tool			2	4,428.0	4,433.0	
12/5/2014		Stage Tool			2	4,389.0	4,494.0	
Logs								
Date		Type				Top, MD (ftKB)	Btm, MD (ftKB)	
12/10/2006		COMPENSATED DENSITY				3,000.0	7,277.0	
12/10/2006		INDUCTION				626.0	7,297.0	
1/3/2007		CBL/CCL/GR				2,800.0	7,220.0	

Well Name: DESHAZO 24-41

VERTICAL - ORIGINAL HOLE, 2/16/2016 3:00:58 PM

Logs

