


**Well Name: MOBILE PREMIX I35-06**

DEVIATED - ORIGINAL HOLE, 10/29/2015 10:05:20 AM

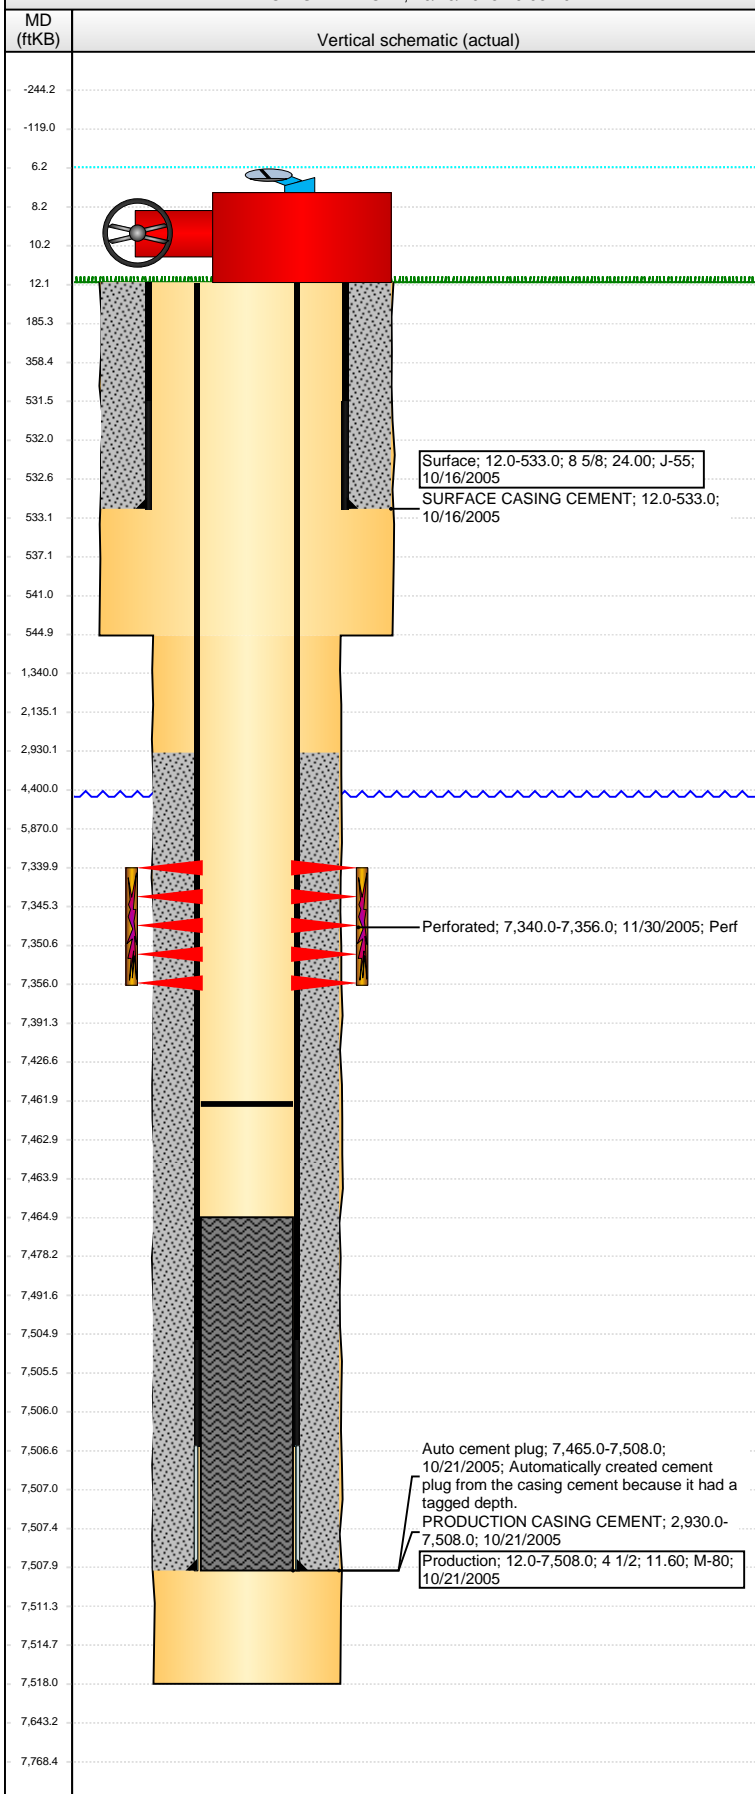

## Well Header

|  |                               |                         |                         |
|--|-------------------------------|-------------------------|-------------------------|
| API<br>05-123-23218                    | Business Unit<br>DJ BASIN     | District<br>15          | Well Config<br>DEVIATED |
| Original KB Elevation (ft)<br>4,690.00 | KB - GL / MSL (ftKB)<br>12.00 | Spud Date<br>10/15/2005 | P & A Date              |

## Comment

8/25/2014: TUBING AND WELLHEAD PULLED FOR REFRAC/RECOMPLETE. COULDN'T GET ZONE TO BREAK. BLEED OFF PSI, SHUT WELL IN, RIG DOWN.

## Directions To Well

"F" STREET & 35TH AVE, N .1, W .9 INTO

## Congressional Location

|           |           |           |           |         |          |              |       |             |
|-----------|-----------|-----------|-----------|---------|----------|--------------|-------|-------------|
| Quarter 1 | Quarter 2 | Quarter 3 | Quarter 4 | Section | Township | Twntshp N... | Range | Rng E/W Dir |
|           |           | SE        | NW        | 35      | 6        | N            | 66    | W           |

## Bottom Hole Location

|                                      |                         |                                    |                         |
|--------------------------------------|-------------------------|------------------------------------|-------------------------|
| North-South Distance (ft)<br>1,995.0 | From N or S Line<br>FNL | East-West Distance (ft)<br>2,052.0 | From E or W Line<br>FWL |
|--------------------------------------|-------------------------|------------------------------------|-------------------------|

## Plug Back Total Depths

| Date       | Depth (ftKB) | Method         | Com              |
|------------|--------------|----------------|------------------|
| 10/21/2005 | 7,465.0      | TAG            | GUIDE SHOE       |
| 11/2/2005  | 7,462.0      | CASED HOLE LOG | DEPTH LOGGER/CBL |

## Wellbore Sections

| Section Des | Size (in) | Act Top, MD (ftKB) | Act Btm, MD (ftKB) |
|-------------|-----------|--------------------|--------------------|
| SURFACE     | 12 1/4    | 12.0               | 545.0              |
| PRODUCTION  | 7 7/8     | 545.0              | 7,518.0            |

## Zone Statuses

| Zone Name | Status Date | Status | Fluid Type | Job            | Prod Method |
|-----------|-------------|--------|------------|----------------|-------------|
| CODELL    | 12/2/2005   | PR     | Oil        | DRILLING/CO... |             |

## Casing Strings

### Surface, 533.0ftKB

| Casing Description | Run Date   | OD (in) | Wt/Len (l... | Grade | Top, MD (ft... | MD (ftKB) |
|--------------------|------------|---------|--------------|-------|----------------|-----------|
| Surface            | 10/16/2005 | 8 5/8   | 24.00        | J-55  | 12.0           | 533.0     |

### Production, 7,508.0ftKB

| Casing Description | Run Date   | OD (in) | Wt/Len (l... | Grade | Top, MD (ft... | MD (ftKB) |
|--------------------|------------|---------|--------------|-------|----------------|-----------|
| Production         | 10/21/2005 | 4 1/2   | 11.60        | M-80  | 12.0           | 7,508.0   |

## Cement

| Description              | Top Depth (ftKB) | Bottom Depth (ftKB) |
|--------------------------|------------------|---------------------|
| SURFACE CASING CEMENT    | 12.0             | 533.0               |
| PRODUCTION CASING CEMENT | 2,930.0          | 7,508.0             |

## Tubing Strings

| Tubing Description  | Run Date   | String... | ID (in) | Wt (lb/ft) | Grade | Len (ft) | Set De... |
|---------------------|------------|-----------|---------|------------|-------|----------|-----------|
| Tubing - Production | 11/11/2005 | 2 3/8     | 1.995   | 4.70       | J-55  | 7,310.00 |           |

## Perforation Data

| Zone                  | Bnch/St g | Entered Shot Total | Top (ftKB) | Btm (ftKB) | Date       |
|-----------------------|-----------|--------------------|------------|------------|------------|
| CODELL, ORIGINAL HOLE |           | 64                 | 7,340.00   | 7,356.00   | 11/30/2005 |

## Stimulations & Treatments

| Date             | Zone                  | Primary Job Type               |
|------------------|-----------------------|--------------------------------|
| 11/30/2005       | CODELL, ORIGINAL HOLE | DRILLING/COMPLETION - ORIGINAL |
| Technical Result |                       | Tech Result Details            |
| Comment          |                       | Tech Result Note               |

## Other In Hole

| Run Date | Des | OD (in) | Top (ftKB) | Btm (ftKB) |
|----------|-----|---------|------------|------------|
|          |     |         |            |            |

## Logs

| Date       | Type                | Top, MD (ftKB) | Btm, MD (ftKB) |
|------------|---------------------|----------------|----------------|
| 10/20/2005 | COMPENSATED DENSITY | 3,000.0        | 7,498.0        |
| 10/20/2005 | INDUCTION           | 533.0          | 7,518.0        |
| 11/3/2005  | CBL/CCL/GR          | 2,770.0        | 7,459.0        |