


**WPX ENERGY ROCKY MOUNTAIN LLC
 FEDERAL RU 32-8
 Rulison Field
 Section 8 T 7S-R93W**

**Formation Tops
 (Measured Depths)**

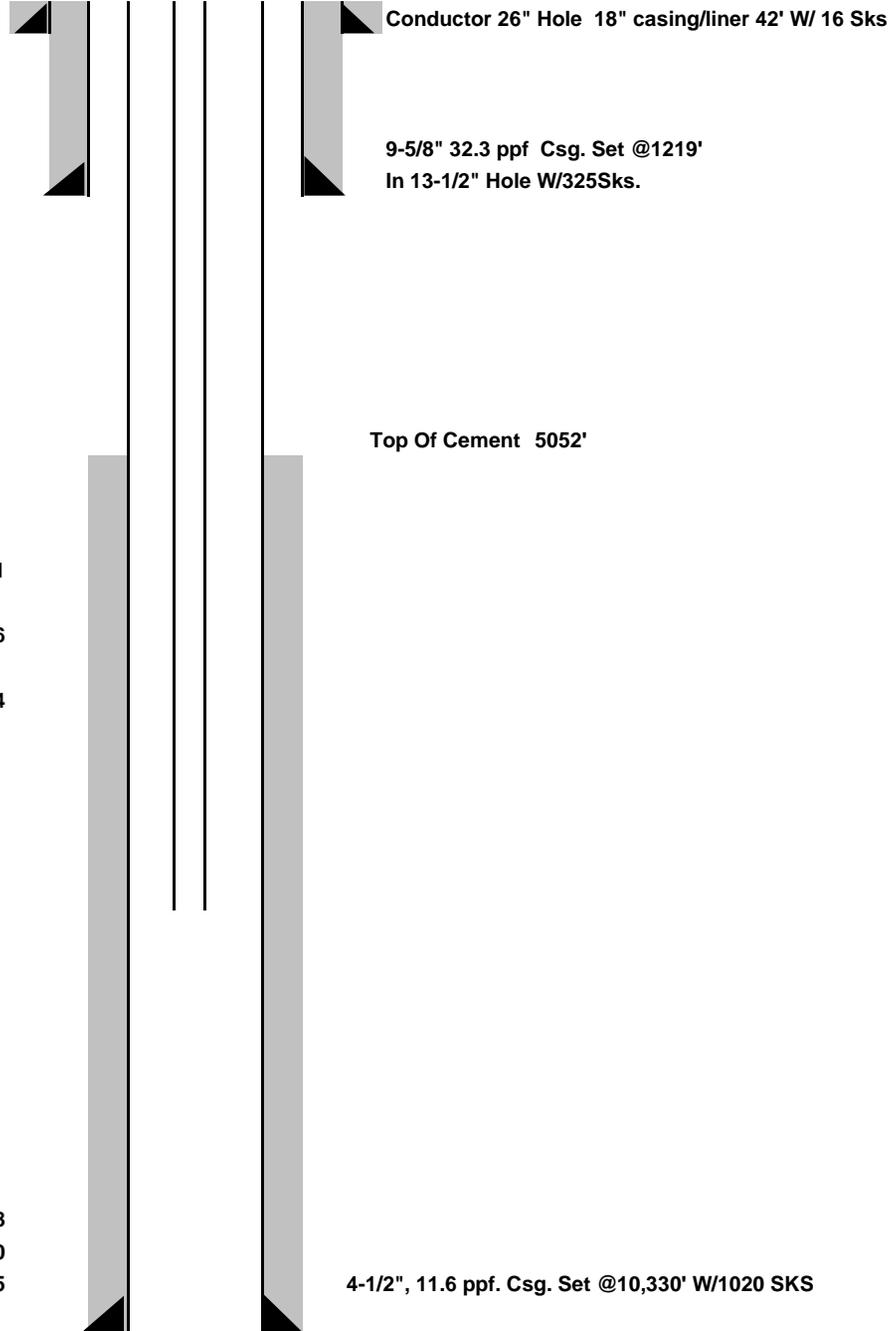

"G" Sand @ 3801
 Mesaverde @ 6456
 Cameo @ 9384

Tubing not set

PBTD @ 10298
 TMD @ 10340
 TVD @ 9945.5

4-1/2", 11.6 ppf. Csg. Set @10,330' W/1020 SKS