

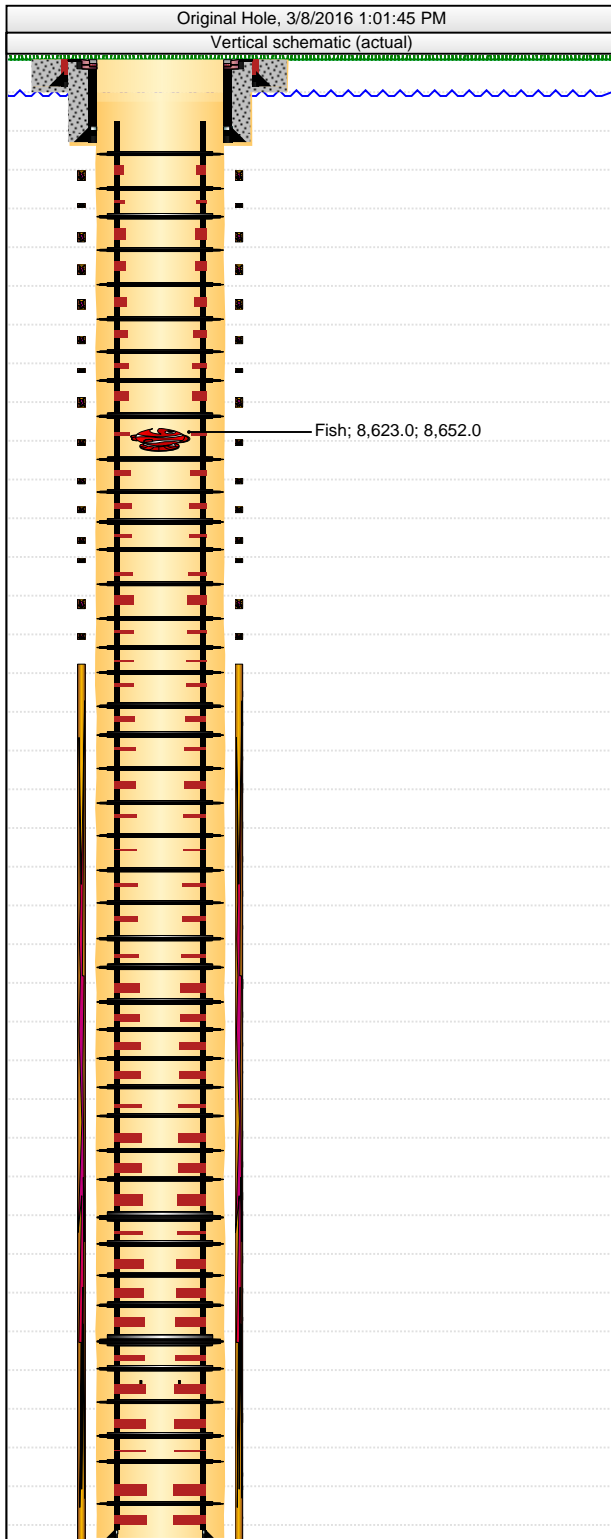
Downhole Well Profile

Well Name: Arellano P-10-9HN

API/UWI 05-123-41109	Surface Legal Location	Field Name wattenberg	License #	State/Province	Well Configuration Type
Original KB Elevation (ft) 4,639.00	KB-Tubing Head Distance (ft)	Spud Date 3/31/2015 04:30	Rig Release Date	PBTD (All)	Total Depth All (TVD) Original Hole - 6,859.0

Wellhead and Christmas Tree Systems

Type	Make	Service	Working Pressure (psi)	Max Pres (psi)	Size (in)
------	------	---------	------------------------	----------------	-----------


Casing Strings

Csg Des	OD (in)	Wt/Len (lb/ft)	Grade	Top Thread	Set Depth (ftKB)
Surface	9 5/8	36.00	J-55	LT&C	789.7
Intermediate	7	29.00	P-110	Buttress Thread	7,290.4
Production	4 1/2	13.50	P-110	Buttress Thread	13,954.0

Perforations

Date	Top (ftKB)	Btm (ftKB)	Linked Zone
------	------------	------------	-------------

Tubing Strings

Tubing Description	Run Date		String Length (ft)		Set Depth (ftKB)		
Item Des	Jts	Make	Model	OD (in)	Wt (lb/ft)	Grade	Len (ft)

Rod Strings

Rod Description	Run Date		String Length (ft)	Set Depth (ftKB)			
Item Des	Jts	Make	Model	OD (in)	Wt (lb/ft)	Grade	Len (ft)