


Downhole Well Profile

Well Name: Arellano Q-10-9HN

API/UWI 05-123-41108	Surface Legal Location	Field Name Wattenberg	License #	State/Province	Well Configuration Type Horizontal
Original KB Elevation (ft) 4,639.00	KB-Tubing Head Distance (ft)	Spud Date 3/30/2015 16:30	Rig Release Date	PBTD (All)	Total Depth All (TVD) Original Hole - 6,873.1

Wellhead and Christmas Tree Systems

Type	Make	Service	Working Pressure (psi)	Max Pres (psi)	Size (in)
------	------	---------	------------------------	----------------	-----------

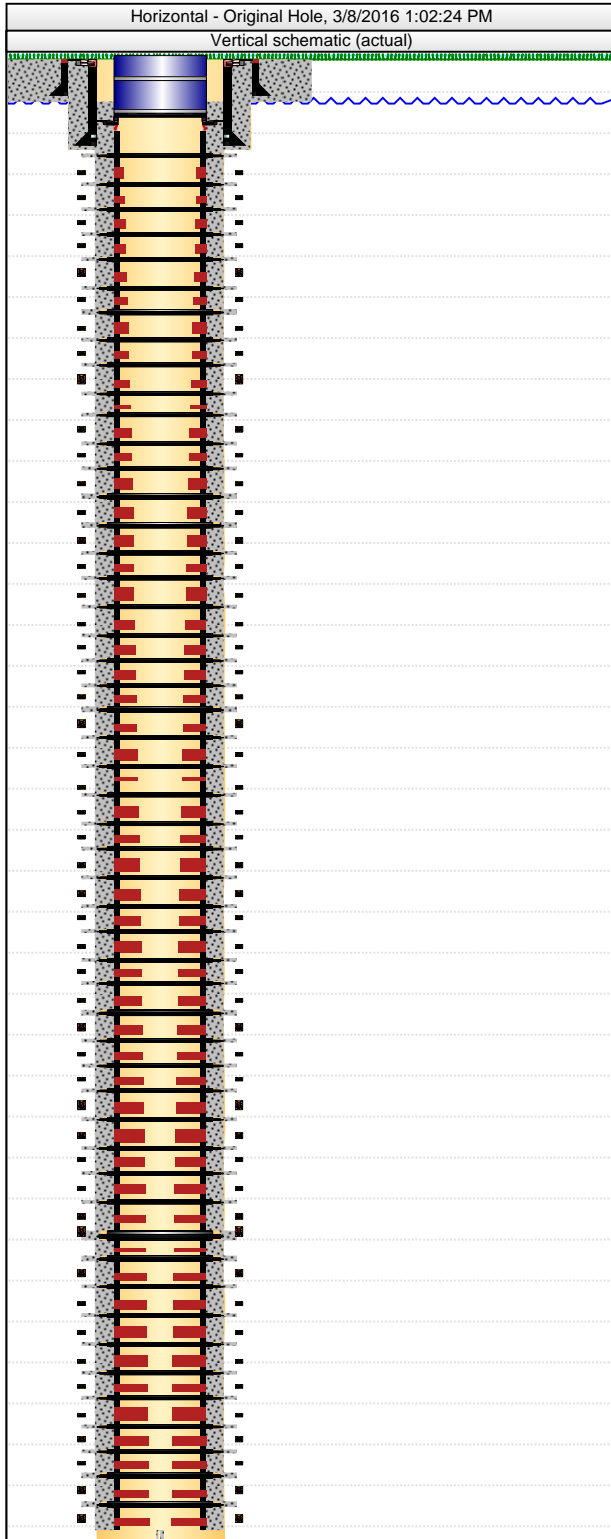

Casing Strings

Csg Des	OD (in)	Wt/Len (lb/ft)	Grade	Top Thread	Set Depth (ftKB)
Surface	9 5/8	36.00	J-55	LT&C	789.9
Intermediate	7	29.00	P-110	Buttress Thread	7,344.7
Production	4 1/2	13.50	P-110	Buttress Thread	13,997.0

Perforations

Date	Top (ftKB)	Btm (ftKB)	Linked Zone
------	------------	------------	-------------

Tubing Strings

Tubing Description	Run Date	String Length (ft)		Set Depth (ft)(KB)			
Casing	9/3/2015	6,673.14		6,685.0			
Item Des	Jts	Make	Model	OD (in)	Wt (lb/ft)	Grade	Len (ft)
Tubing	1		T&C Upset	4 1/2	13.50	P-110	45.50
Tubing Pup Joint	1			4 1/2	13.50	P-110	5.66
Tubing	14		T&C Non-Upset	4 1/2	13.50	P-110	6,606.60
Tubing Pup Joint	1			4 1/2	13.50	P-110	5.07
Seal Assembly	1			4 1/2	13.50	P-110	10.31

Rod Strings

Rod Description		Run Date		String Length (ft)		Set Depth (ft)KB	
Item Des	Jts	Make	Model	OD (in)	Wt (lb/ft)	Grade	Len (ft)