


Downhole Well Profile

Well Name: Arellano N-10-9HN

API/UWI 05-123-41112	Surface Legal Location NESE Sec 10-5N-65W	Field Name Wattenberg	License #	State/Province Colorado	Well Configuration Type Horizontal
Original KB Elevation (ft) 4,639.00	KB-Tubing Head Distance (ft)	Spud Date 3/29/2015 02:30	Rig Release Date 5/20/2015 14:00	PBTD (All)	Total Depth All (TVD) Original Hole - 6,842.2

Wellhead and Christmas Tree Systems

Type	Make	Service	Working Pressure (psi)	Max Pres (psi)	Size (in)
------	------	---------	------------------------	----------------	-----------

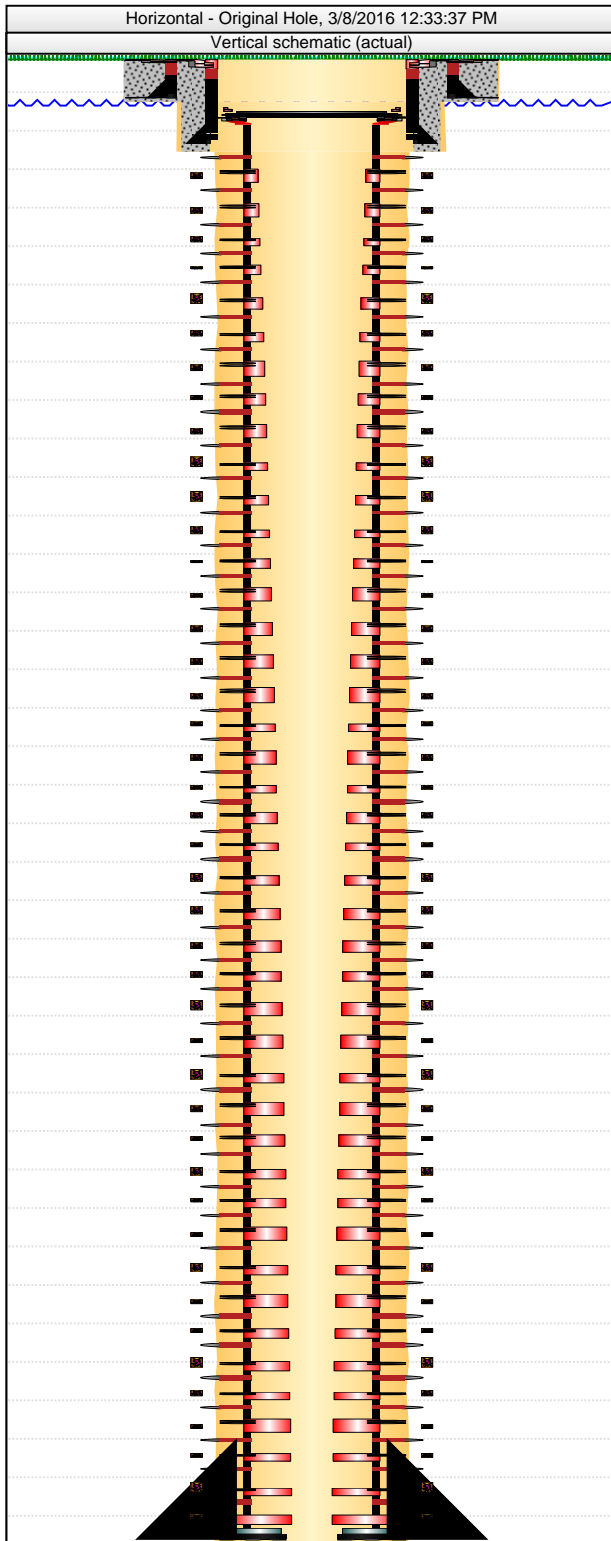

Casing Strings

Csg Des	OD (in)	Wt/Len (lb/ft)	Grade	Top Thread	Set Depth (ftKB)
Surface	9 5/8	36.00	J-55	LT&C	790.1
Intermediate	7	29.00	P-110	Buttress Thread	7,301.5
Production	4 1/2	13.50	P-110	Buttress Thread	13,940.0

Perforations

Date	Top (ftKB)	Btm (ftKB)	Linked Zone
------	------------	------------	-------------

Tubing Strings

Tubing Description	Run Date		String Length (ft)		Set Depth (ftKB)		
Item Des	Jts	Make	Model	OD (in)	Wt (lb/ft)	Grade	Len (ft)

Rod Strings

Rod Description	Run Date		String Length (ft)	Set Depth (ftKB)			
Item Des	Jts	Make	Model	OD (in)	Wt (lb/ft)	Grade	Len (ft)