


Well Name: **MOORE 01**

VERTICAL - ORIGINAL HOLE, 3/14/2016 4:51:21 PM

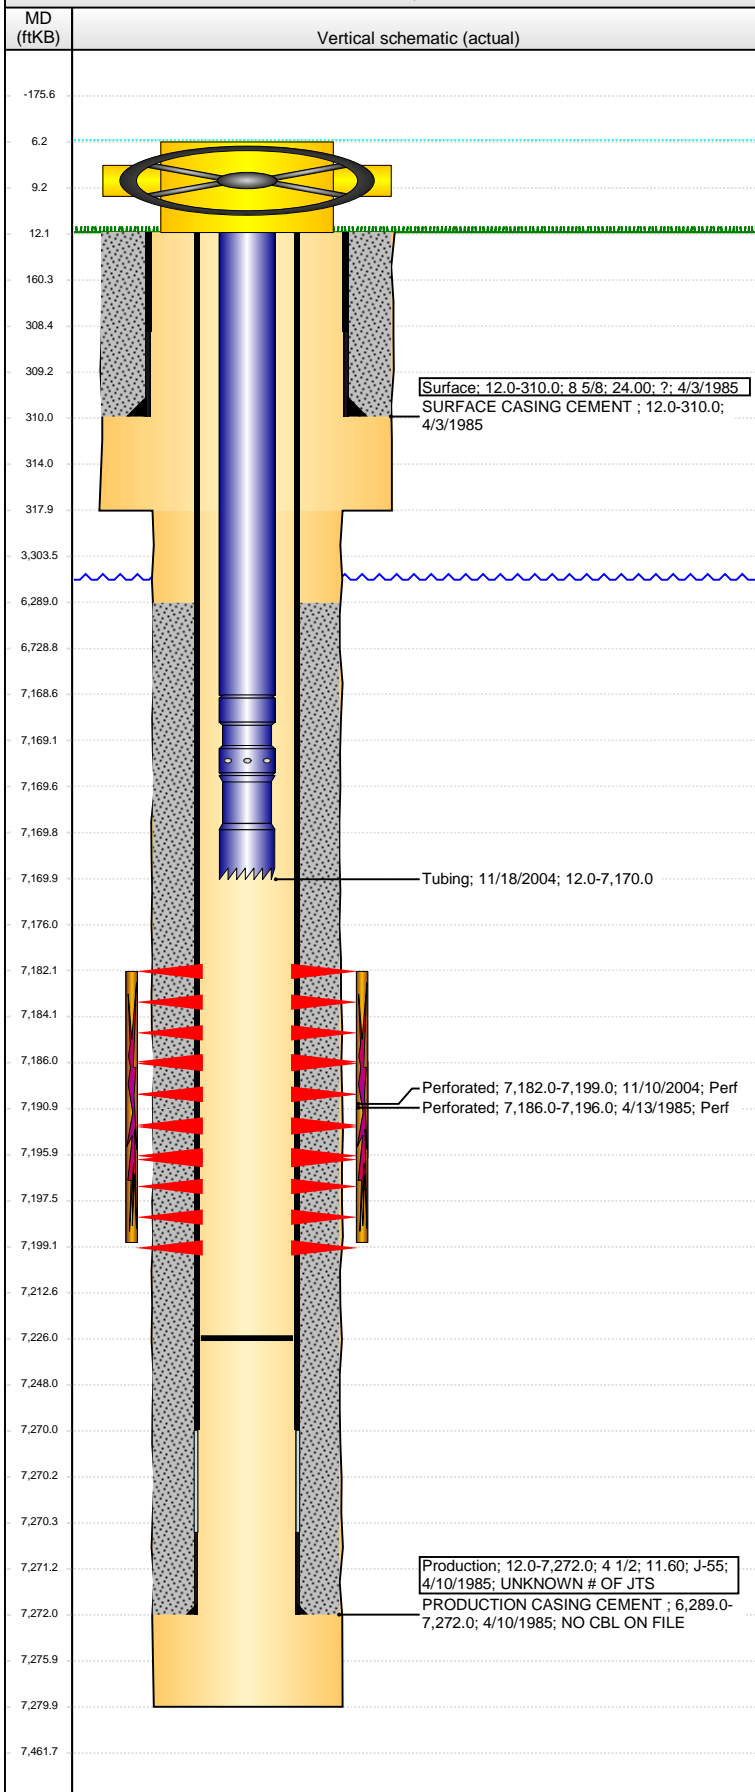

Well Header			
API	Business Unit	District	Well Config
05-123-12379	DJ BASIN	15	VERTICAL
Original KB Elevation (ft)	KB - GL / MSL (ftKB)	Spud Date	P & A Date
4,790	12.00	4/3/1985	
Comment			
WELL DATA VERY SPARSE.			
NO CBL ON FILE			
Directions To Well			
Congressional Location			
Quarter 1	Quarter 2	Quarter 3	Quarter 4
		NE	NE
Section	Township	Twship N...	Range
13	6	N	66
W			
Bottom Hole Location			
North-South Distance (ft)		From N or S Line	East-West Distance (ft)
			From E or W Line
Plug Back Total Depths			
Date	Depth (ftKB)	Method	Com
2/5/1990	7,230.0	TAG	CLEAN OUT
11/18/2004	7,226.0	TAG	CLEAN OUT & LAND TBG
Wellbore Sections			
Section Des	Size (in)	Act Top, MD (ftKB)	Act Btm, MD (ftKB)
SURFACE	12 1/4	12.0	318.0
PRODUCTION	7 7/8	318.0	7,280.0
Zone Statuses			
Zone Name	Status Date	Status	Fluid Type
CODELL	5/1/1985	PR	
CODELL	12/27/2004	PR	
Casing Strings			
Surface, 310.0ftKB			
Casing Description	Run Date	OD (in)	Wt/Len (l...)
Surface	4/3/1985	8 5/8	24.00
Production, 7,272.0ftKB			
Casing Description	Run Date	OD (in)	Wt/Len (l...)
Production	4/10/1985	4 1/2	11.60
Cement			
Description	Top Depth (ftKB)	Bottom Depth (ftKB)	
SURFACE CASING CEMENT	12.0	310.0	
PRODUCTION CASING CEMENT	6,289.0	7,272.0	
Tubing Strings			
Tubing Description	Run Date	String...	ID (in)
Tubing	11/18/2004	2 3/8	1.995
Tubing Components			
Item Des	OD (in)	Wt (lb/ft)	Grade
EUE 8rd Tubing	2 3/8	4.70	J-55
Pump Seating	2 3/8	1.10	
Notched collar	2 3/8		
Perforation Data			
Zone	Bnch/St g	Entered Shot Total	Top (ftKB)
CODELL, ORIGINAL HOLE		68	7,182.00
CODELL, ORIGINAL HOLE		30	7,186.00
Stimulations & Treatments			
Date	Zone	Primary Job Type	
4/18/1985	CODELL, ORIGINAL HOLE	DRILLING/COMPLETION - ORIGINAL	
Technical Result		Tech Result Details	Tech Result Note
Comment			
Date	Zone	Primary Job Type	
11/15/2004	CODELL, ORIGINAL HOLE	RE-FRAC	
Technical Result		Tech Result Details	Tech Result Note
Comment			

Well Name: MOORE 01

VERTICAL - ORIGINAL HOLE, 3/14/2016 4:51:24 PM

Other In Hole

Run Date	Des	OD (in)	Top (ftKB)	Btm (ftKB)

Logs

Date	Type	Top, MD (ftKB)	Btm, MD (ftKB)
4/9/1985	COMPENSATED DENSITY	3,700.0	7,272.0
4/9/1985	INDUCTION	310.0	7,269.0
11/10/2004	GAMMA RAY	6,750.0	7,228.0
10/28/2014	GYRO	10.0	7,000.0

