





Lat40°, Inc. 6250 W. 10th Street, Unit 2, Greeley, CO 970-515-5294

WELL LOCATION CERTIFICATE

SHADOW A26-622

SECTION: 30
TOWNSHIP: 6N
RANGE: 63W
6TH. P.M.
WELD COUNTY, CO

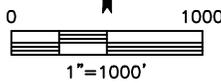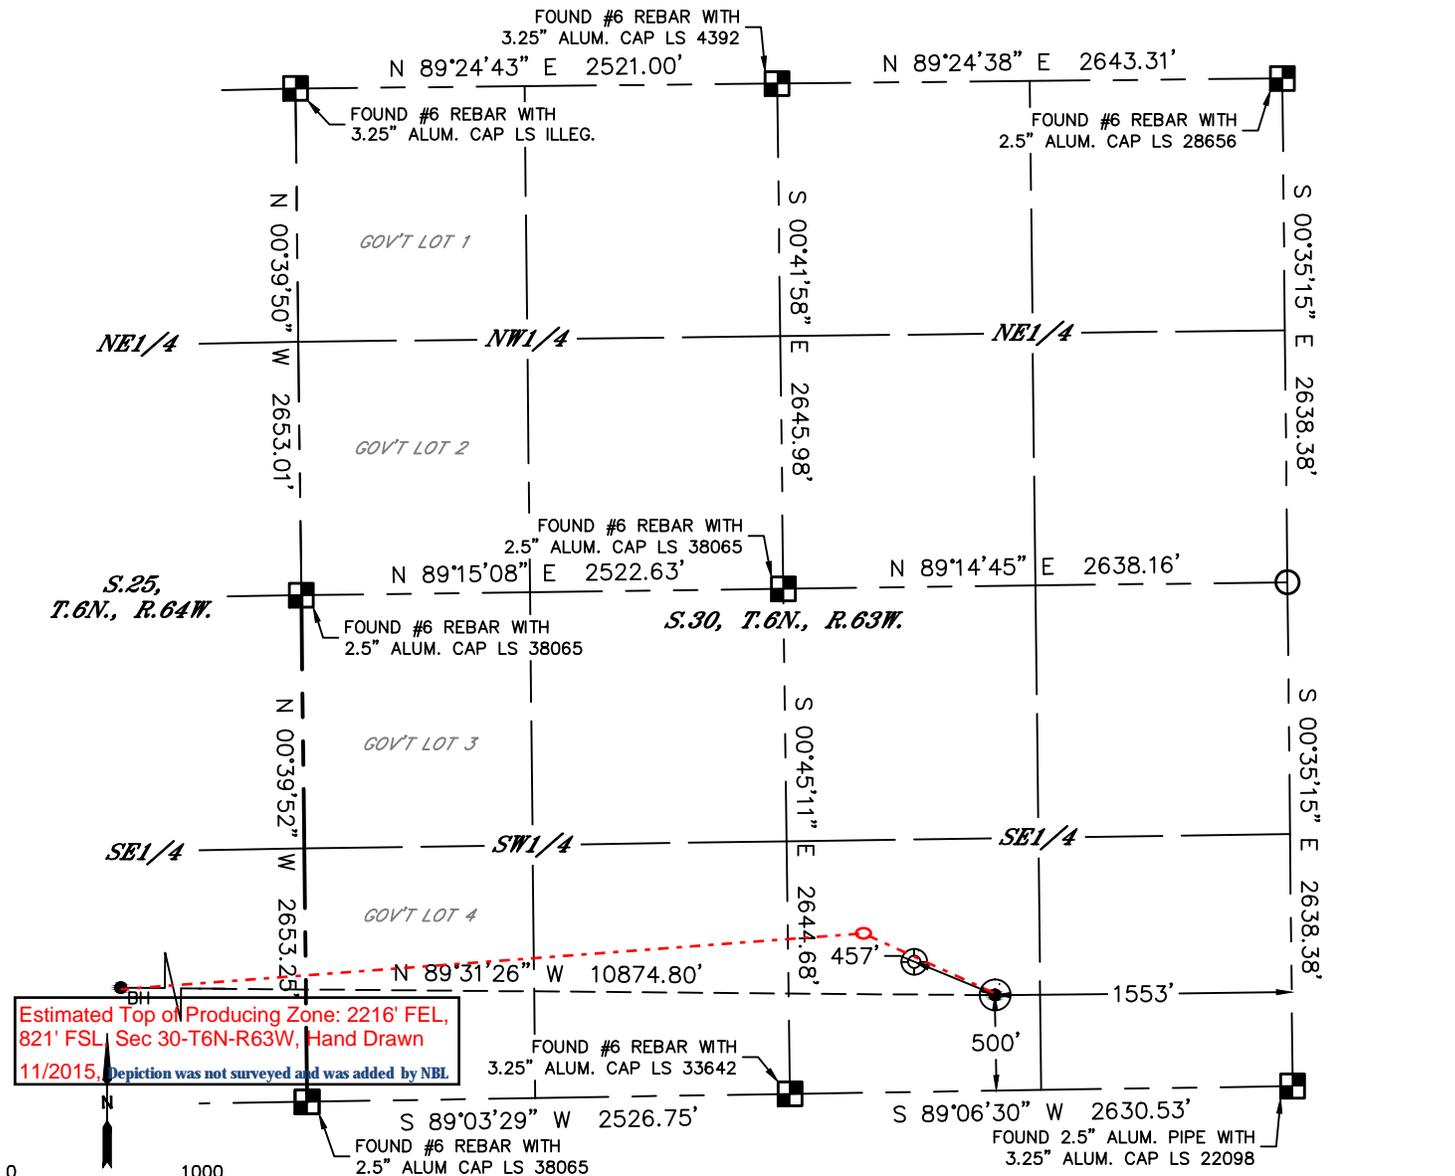

- LEGEND
- = ALIQUOT MONUMENT AS DESCRIBED
 - = CALCULATED POSITION
 - ⊙ = SURFACE HOLE LOCATION (SHL)
 - ▲ = ENTRY POINT LOCATION (EP)
 - = BOTTOM HOLE LOCATION (BHL)
 - ⊕ = EXISTING WELL
 - ⊖ = ABANDONED WELL


| CLIENT: NOBLE ENERGY, INC. | | | | LANDMAN: CORY NEIGHBORS | | | |
|-----------------------------------|----------|--------------|------------|-------------------------|-------------|------------------------|--|
| INSTRUMENT OPERATOR: CHASE MILLER | | | | SURVEY DATE: 8/4/2015 | | SURFACE USE: CROP LAND | |
| SHL FOOTAGE | SHL LAT° | SHL LONG° | SHL PDOP | SHL ELEV (FT.) | SHL 1/4/1/4 | SHL S-T-R | |
| 500 | FSL 1553 | FEL 40.45163 | -104.47582 | 2.2 | 4638 | SWSE 30-6-63 | |

| BHL FOOTAGE | BHL LAT° | BHL LONG° | BHL S-T-R |
|-------------|----------|--------------|--------------------|
| 780 | FSL 1970 | FEL 40.45221 | -104.51487 26-6-64 |

| NEAREST EXISTING WELL IN SHL 1/4/1/4 | |
|--------------------------------------|----------|
| EXISTING LARSEN FAIRMEADOWS 2-30 | ±457' NW |
| NEAREST CULTURAL ITEMS | |
| BUILDING | ±546' SE |
| BUILDING UNIT | ±684' SE |
| HIGH OCCUPANCY BUILDING UNIT | 5280'+ |
| DESIGNATED OUTSIDE ACTIVITY AREA | 5280'+ |
| PUBLIC ROAD (COUNTY ROAD 64) | ±493' S |
| ABOVE GROUND UTILITY | ±526' S |
| RAILROAD | 5280'+ |
| PROPERTY LINE | ±237' E |

NOTE:

- Bearings shown are Grid Bearings of the Colorado State Plane Coordinate System, North Zone, North American Datum 1983. The lineal dimensions as contained herein are based upon the "U.S. Survey Foot."
- Distances to section lines measured at 90 degrees from said section lines.
- Ground elevations are based on an observed GPS elevation (NAVD 1988 DATUM).
- Latitude and Longitude shown are (NAD 83 DATUM).
- IMPROVEMENTS: See LOCATION DRAWING for all visible improvements within 500' of oil and gas location.
- This map does not represent a boundary survey.

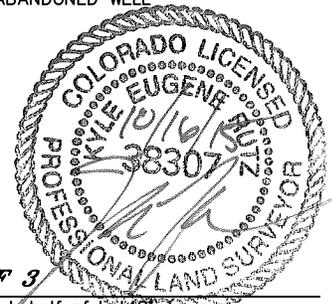

SHEET 1 OF 3
 Kyle E. Rutz-On behalf of Lat40°, Inc.
 Colorado Licensed Professional Land Surveyor No. 38307
 DATE: 10/16/2015
 PROJECT#: 2014163




Lat40°, Inc. 6250 W. 10th Street, Unit 2, Greeley, CO 970-515-5294

WELL LOCATION CERTIFICATE


SHADOW A26-622

SECTION: 30
TOWNSHIP: 6N
RANGE: 63W
6TH. P.M.
WELD COUNTY, CO

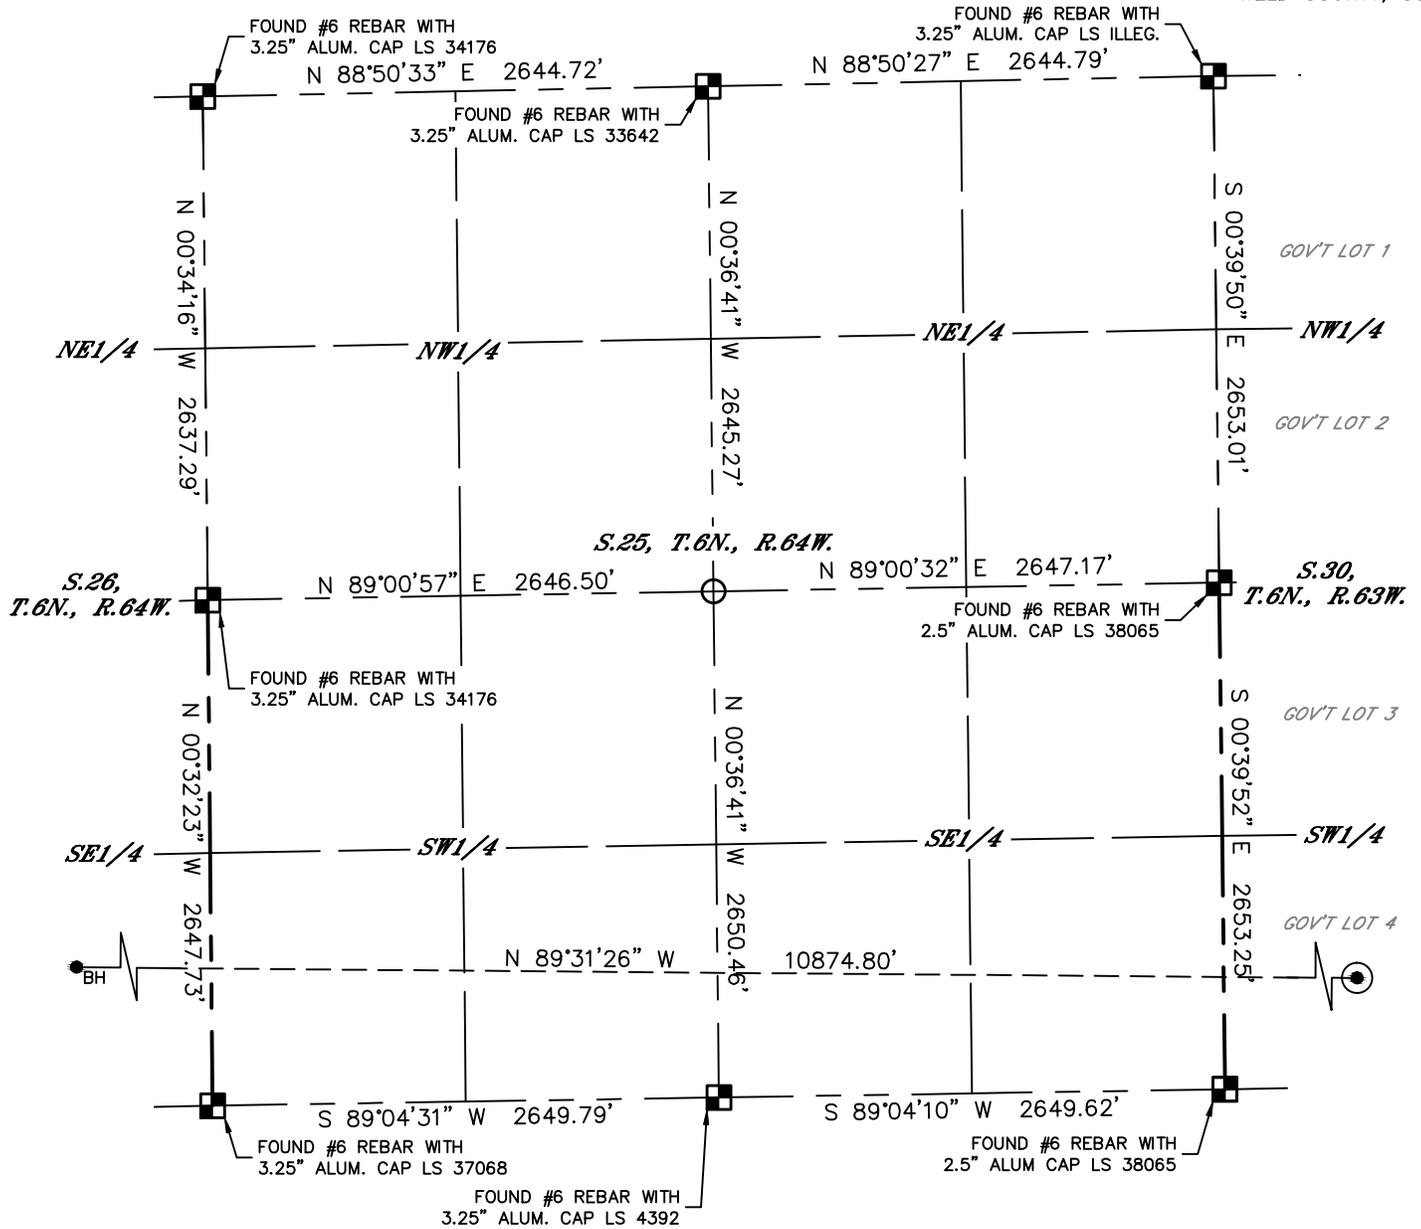

LEGEND

- = ALIQUOT MONUMENT AS DESCRIBED
- = CALCULATED POSITION
- ⊙ = SURFACE HOLE LOCATION (SHL)
- ▲ = ENTRY POINT LOCATION (EP)
- = BOTTOM HOLE LOCATION (BHL)
- ⊕ = EXISTING WELL
- ⊖ = ABANDONED WELL

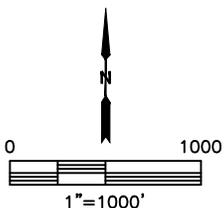

SHEET 2 OF 3

Kyle E. Rutz—On behalf of Lat40, Inc.
Colorado Licensed Professional Land Surveyor No. 38307
DATE: 10/16/2015
PROJECT#: 2014163




Lat40°, Inc. 6250 W. 10th Street, Unit 2, Greeley, CO 970-515-5294

WELL LOCATION CERTIFICATE


SHADOW A26-622

SECTION: 30
TOWNSHIP: 6N
RANGE: 63W
6TH. P.M.
WELD COUNTY, CO

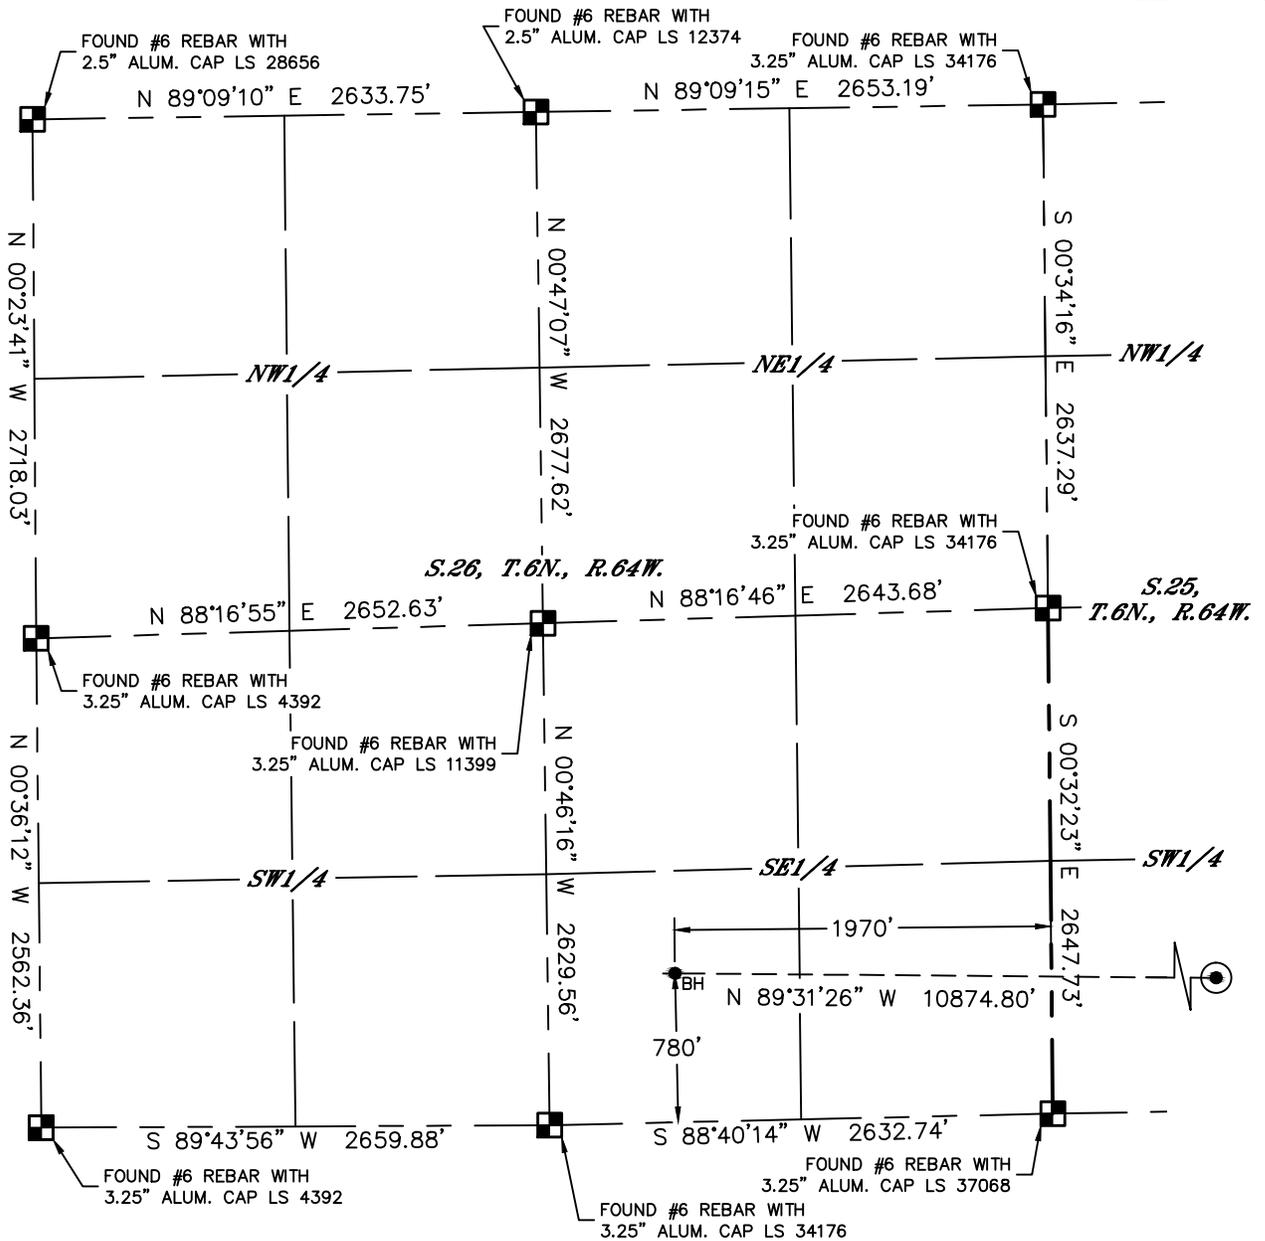

LEGEND

- = ALIQUOT MONUMENT AS DESCRIBED
- = CALCULATED POSITION
- ⊙ = SURFACE HOLE LOCATION (SHL)
- ▲ = ENTRY POINT LOCATION (EP)
- = BOTTOM HOLE LOCATION (BHL)
- ⊕ = EXISTING WELL
- ⊖ = ABANDONED WELL

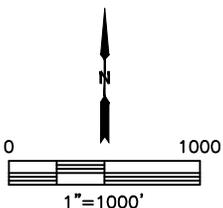

SHEET 3 OF 3

Kyle E. Rutz—On behalf of Lat40°, Inc.
 Colorado Licensed Professional Land Surveyor No. 38307
 DATE: 10/16/2015
 PROJECT#: 2014163