

UNITED STATES
DEPARTMENT OF THE INTERIOR
BUREAU OF LAND MANAGEMENT

Budget Bureau No. 1004-0135

Expires: March 31, 1993

5. Lease Designation and Serial No.

CO-02745

6. If Indian, Allottee or Tribe Name

N/A

7. If Unit or CA, Agreement Designation

Fork Unit

8. Well Name and No.

5-32-1-1

9. API Well No.

05-103-08475

10. Field and Pool, or Exploratory Area

Fork Unit

11. County or Parish, State

Rio Blanco, Colorado

SUNDRY NOTICES AND REPORTS ON WELLS

Do not use this form for proposals to drill or to deepen or reentry a different reservoir.
Use "APPLICATION FOR PERMIT -" for such proposals

SUBMIT IN TRIPLICATE

1. Type of Well

Oil Well Gas Well Other

2. Name of Operator

Chandler & Associates, Inc.

3. Address and Telephone No.

475 17th Street, Suite 1000, Denver, CO 80202 970-675-8451

4. Location of Well (Footage, Sec., T., R., m., or Survey Description)

1026' FWL, 2122' FNL, (SWNW) Sec. 32, T1S, R101W

12. CHECK APPROPRIATE BOX(S) TO INDICATE NATURE OF NOTICE, REPORT, OR OTHER DATA

TYPE OF SUBMISSION

TYPE OF ACTION

Notice of Intent
 Subsequent Report
 Final Abandonment Notice

Abandonment
 Recompletion
 Plugging Back
 Casing Repair
 Altering Casing
 Other

Change of Plans
 New Construction
 Non-Routine Fracturing
 Water Shut-Off
 Conversion to Injection
 Dispose Water

(Note: Report results of multiple completion on Well Completion or Recompletion Report and Log form.)

13. Describe Proposed or Completed Operations (Clearly state all pertinent details, and give pertinent dates, including estimated date of starting any proposed work. If well is directionally drilled, give subsurface locations and measured and true vertical depths for all markers and zones pertinent to this work.)*

Please be advised that this well was plugged and abandoned by Rippy, Inc. in June, 1997. The following procedure was witnessed by BLM personnel:

- 1) Perforations were shot @ 5300' and squeezed with 70 sx. Cement was tagged @ 5060'
- 2) Casing was cut and pulled from 2381' - surface.
- 3) A 30 sk plug was placed from 2260' and tagged @ 2170'.
- 4) A 90 sk plug was placed from 800'-500'.
- 5) A 17 sk plug was spotted from 35' to surface.

Upon inspection and approval by BLM personnel, the location will be reclaimed and rehabbed.

RECEIVED
 1997 AUG 11 PM 12:53
 BUREAU OF LAND MANAGEMENT
 FORT COLLINS, CO. 80541-0528

14. I hereby certify that the foregoing is true and correct

Signed

James A. Simon

Title Operations/Production Supervisor

Date

08/06/97

(This space for Federal or State office use)

Approved by

Brad Lany

Title Petroleum Engineer

Date

8/14/97

Conditions of approval, if any:

"Conditions of Approval Attached!"

Title 18 U.S.C. Section 1001, makes it a crime for any person knowingly and willfully to make to any department or agency of the United States any false, fictitious or fraudulent statements or representations as to any matter within its jurisdiction.

***See Instructions on Reverse Side**

CONDITIONS OF APPROVAL
for
Sundry Notice Dated 8/06/97

Operator: Chandler & Associates

Well No.: 5-32-1-1

Lease No.: COC-02745



Location: T1S R101W SWNW S32

1. Upon completion of all well location and access road reclamation, including establishment of an adequate stand of vegetation, you will submit a final abandonment notice (FAN) notifying the BLM that the location is ready for release. Approval of the FAN is considered the final release of the location and will not occur until an onsite inspection has been completed by the BLM.

Final Plug & Abandonment


Well Name: Fork Unit 5-32-1-1
 Location: SWNW Sec. 32, T1S, R101W
 Field: Fork Unit
 Spud Date: 1-3-80
 Completed: 2-5-80

Date: 7-30-97
 County: Rio Blanco
 State: Colorado
 KB: 5958'
 GL: 5944'

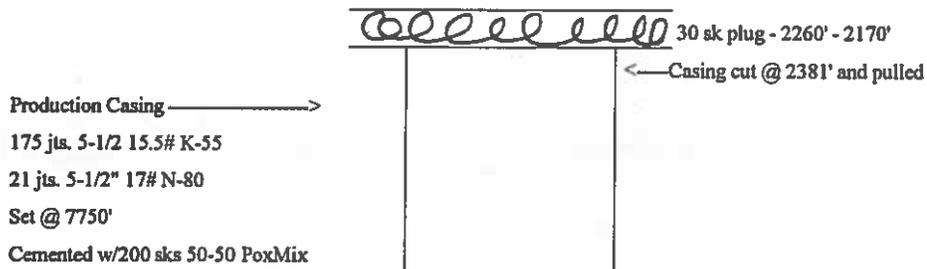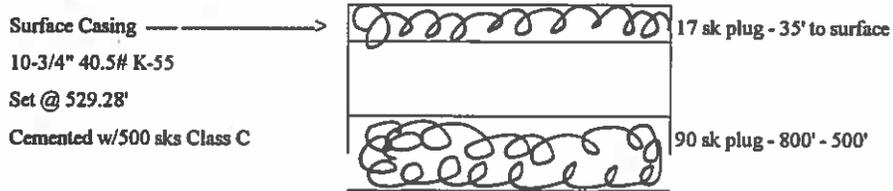

Formation Tops:

Castlegate	1076'
Mancos	2295'
Mancos "B"	2365'
Dakota	5138'
Morrison	5389'
Entrada	6004'
Shinarump	6953'
Moenkopi	7010'
Weber	7587'
Marron	7721'

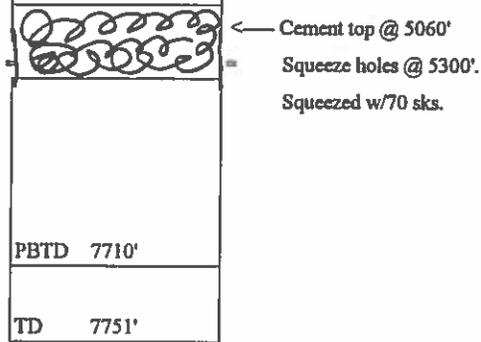

RIPPY, INC.

Rippy Sales & Service
P. O. Box 667
Fruita, Co. 81521

DATE 7/2/97

CEMENTING AFFIDAVIT

PULLING & PLUGGING REPORT

COMPANY Chandler & Associates, Inc.

LEASE _____ WELL NO. FU# 5-32-1-1

SECTION 32 TOWNSHIP 1S RANGE 101 W UNIT Forklift COUNTY Rio Blanco

2381 FT. OF 5 1/2" CASING RECOVERED

_____ FT. OF _____ CASING RECOVERED

PLUGS SET

- | | | | | | |
|-----|-------------|--|-----|-----------------------|-----|
| 1. | <u>Perf</u> | SAX CEMENT SET AT <u>5300</u> | FT. | TO _____ | FT. |
| 2. | <u>70</u> | SAX CEMENT SET AT <u>5300</u> | FT. | TO <u>Log at 5060</u> | FT. |
| 3. | <u>30</u> | SAX CEMENT SET AT <u>2260</u> | FT. | TO <u>Log at 2170</u> | FT. |
| 4. | <u>90</u> | SAX CEMENT SET AT <u>800</u> | FT. | TO <u>500</u> | FT. |
| 5. | <u>17</u> | SAX CEMENT SET AT <u>Surface</u> | FT. | TO _____ | FT. |
| 6. | _____ | SAX CEMENT SET AT _____ | FT. | TO _____ | FT. |
| 7. | _____ | SAX CEMENT SET AT _____ | FT. | TO _____ | FT. |
| 8. | _____ | SAX CEMENT SET AT _____ | FT. | TO _____ | FT. |
| 9. | _____ | SAX CEMENT SET AT _____ | FT. | TO _____ | FT. |
| 10. | _____ | SAX CEMENT SET AT _____ | FT. | TO _____ | FT. |
| 11. | _____ | SAX CEMENT SET AT _____ | FT. | TO _____ | FT. |
| 12. | _____ | SAX CEMENT SET AT _____ | FT. | TO _____ | FT. |

Squeeze

*BLM Rep on site during job,
all plugs witnessed & okayed
by BLM Reps.*

SIGNED W. J. Rippy Jr.
RIPPY, INC.