

FRANE SURVEYING INC.


Physical Address: 34834 Annie Cir.
Mail to: Box 2372, Elizabeth, CO 80107
Ph. 303-243-0037
www.franesurveying.com
Job # 078-15 Big Jake #1-18

Frane Surveying, in accordance with a request from Grand Mesa Operating has determined the location of Big Jake #1-18 to be 2525 Feet FSL, and 1647 Feet FWL, (90° off Section lines) of Section 18, Township 5s, Range 53w of the 6th Principal Meridian, Washington County, Colorado.

Date: Staked on 12/21/15 drawn on 12/28/15.

Re: Staked by Elijah Frane
Drawn: Drawn by Elijah Frane

Location Drawing

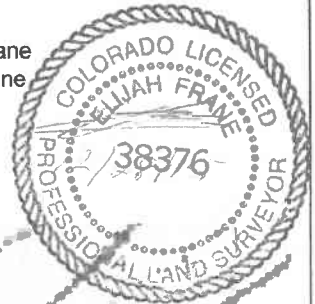

There are no apparent improvements within 500' of proposed well pad.

Grand Mesa Operating
SW 1/4 SEC. 18-5s-53w
Big Jake #1-18
Washington, Co. COLORADO

5/33

300'

300'

500'

18