

# WELLBORE SKETCH After

Operator/Well D & C Rousta-bout Service

Elevation:

Location East Bar X #1 (Hancock Gov't. #1)

Ground Level 4831


NWSE, Sec. 33, T8S, R104W, 6th PMZ

Derrick Floor \_\_\_\_\_

Mesa County, Colorado

Kelly Bushing \_\_\_\_\_

API # 05-077-05187 Lease # C-02508D

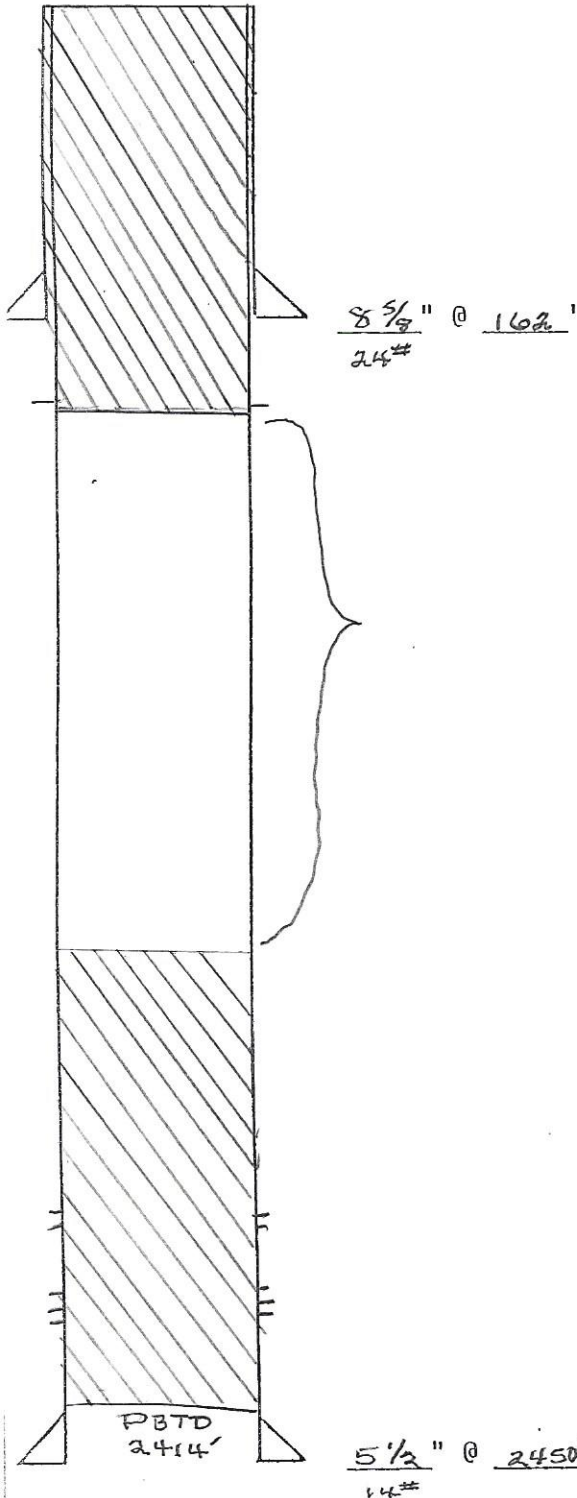

Perf @ 203' + pump 60 SX plug  
from 203' to surface

Fill w/ 9# mud after pressure  
testing 5 1/2 casing

Top of bottom plug (60 SX plug)

## Dakota Perfs

Upper Perfs 2328 - 2338 - 4 SPF

Lower Perfs 2368 - 2398 - 4 SPF

PBTD - 2414'

# WELLBORE SKETCH

Operator/Well D & G Rowstabout Service

Elevation:

Location East Bar X #1 (Hancock Gout #1

Ground Level 4831

NW SE, Sec. 33, T8S, R104W, 6th PM

Derrick Floor \_\_\_\_\_

Mesa County, Colorado

Kelly Bushing \_\_\_\_\_

API # 05-077-05127 Lease # C-02508 D

