



FOUNDATION ENERGY MANAGEMENT, LLC

Foundation Energy Management, LLC
16000 North Dallas Parkway, Suite 875
Dallas, Texas 75248

March 29, 2016

Colorado Oil and Gas Corporation Commission
1120 Lincoln Street, Suite 801
Denver, Colorado 80203
ATTN: Rob Young

RE: SPILL ID# 443564

Dear Mr. Rob Young,

Foundation Energy Management, LLC (Foundation) is submitting the sampling results for the Spill ID# 443564, Godsey #11-20.

Below is a table that outlines what samples we took and their thresholds. Attached to this letter is the complete sampling report and a map of where the samples were taken.

Location of Sample	Depth of Sample	Tested for	Sample Taken Date	Sample Result	Table 910-1 Standard	Below Standards?
Background 1 (1366773)	0-6"	pH	3/21/2016	7.6	6-9	YES
Background 2 (1366774)	6-36"	pH	3/21/2016	8.1	6-9	YES
E 1 (1366775)	0-6"	pH	3/21/2016	8	6-9	YES
E 2 (1366776)	6-36"	pH	3/21/2016	8.5	6-9	YES
W 1 (1366777)	0-6"	pH	3/21/2016	7.2	6-9	YES
W 2 (1366778)	6-36"	pH	3/21/2016	7.8	6-9	YES
Background 1 (1366773)	0-6"	SAR	3/21/2016	0.16	< 12	YES
Background 2 (1366774)	6-36"	SAR	3/21/2016	2.8	< 12	YES
E 1 (1366775)	0-6"	SAR	3/21/2016	0.64	< 12	YES
E 2 (1366776)	6-36"	SAR	3/21/2016	9.93	< 12	YES
W 1 (1366777)	0-6"	SAR	3/21/2016	0.78	< 12	YES
W 2 (1366778)	6-36"	SAR	3/21/2016	3.05	< 12	YES
Background 1 (1366773)	0-6"	EC	3/21/2016	0.36	< 4 mmhos/cm or 2x Background	YES
Background 2 (1366774)	6-36"	EC	3/21/2016	0.32	< 4 mmhos/cm or 2x Background	YES
E 1 (1366775)	0-6"	EC	3/21/2016	0.42	< 4 mmhos/cm or 2x Background	YES
E 2 (1366776)	6-36"	EC	3/21/2016	0.56	< 4 mmhos/cm or 2x Background	YES
W 1 (1366777)	0-6"	EC	3/21/2016	0.34	< 4 mmhos/cm or 2x Background	YES
W 2 (1366778)	6-36"	EC	3/21/2016	0.32	< 4 mmhos/cm or 2x Background	YES

Tulsa Office

15 East 5th Street, Suite 1200
Tulsa, Oklahoma 74103
P: 918-526-5510 F: 918-585-1660

Corporate Office

16000 Dallas Parkway, Suite 875
Dallas, Texas 75248
P: 972-707-2500 F: 972-934-8610

Denver Office

1801 Broadway, Suite 1500
Denver, Colorado 80202
P: 303-244-8100 F: 303-861-0604



FOUNDATION
ENERGY MANAGEMENT, LLC

Foundation Energy Management, LLC
16000 North Dallas Parkway, Suite 875
Dallas, Texas 75248

Please contact me at (918) 526-5591 or cohair@foundationenergy.com if you have any questions.

Regards,

Caitlin O'Hair
HSE/Regulatory Tech

Tulsa Office

15 East 5th Street, Suite 1200
Tulsa, Oklahoma 74103
P: 918-526-5510 F: 918-585-1660

Corporate Office

16000 Dallas Parkway, Suite 875
Dallas, Texas 75248
P: 972-707-2500 F: 972-934-8610



Denver Office

1801 Broadway, Suite 1500
Denver, Colorado 80202
P: 303-244-8100 F: 303-861-0604

DATE REPORTED: 03/28/2016

Analysis By: American Agricultural Lab Recommendations By: American Agricultural Lab Electronically Approved by: **Kevin Grooms**

Godsey 11-20

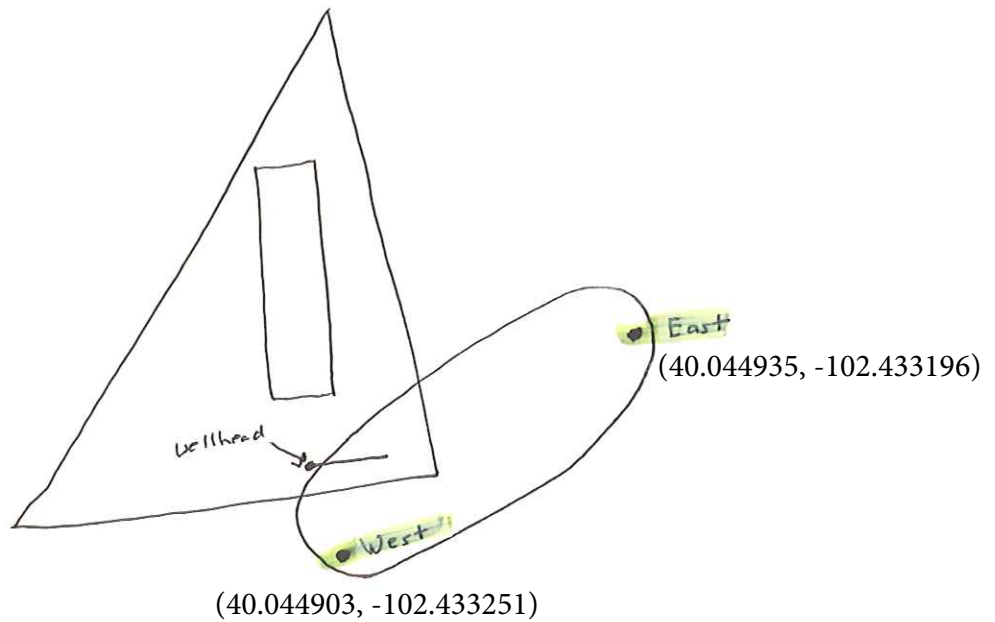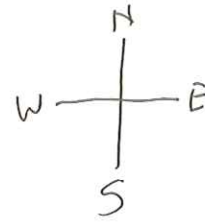

Background

(40.044867, -102.433251)