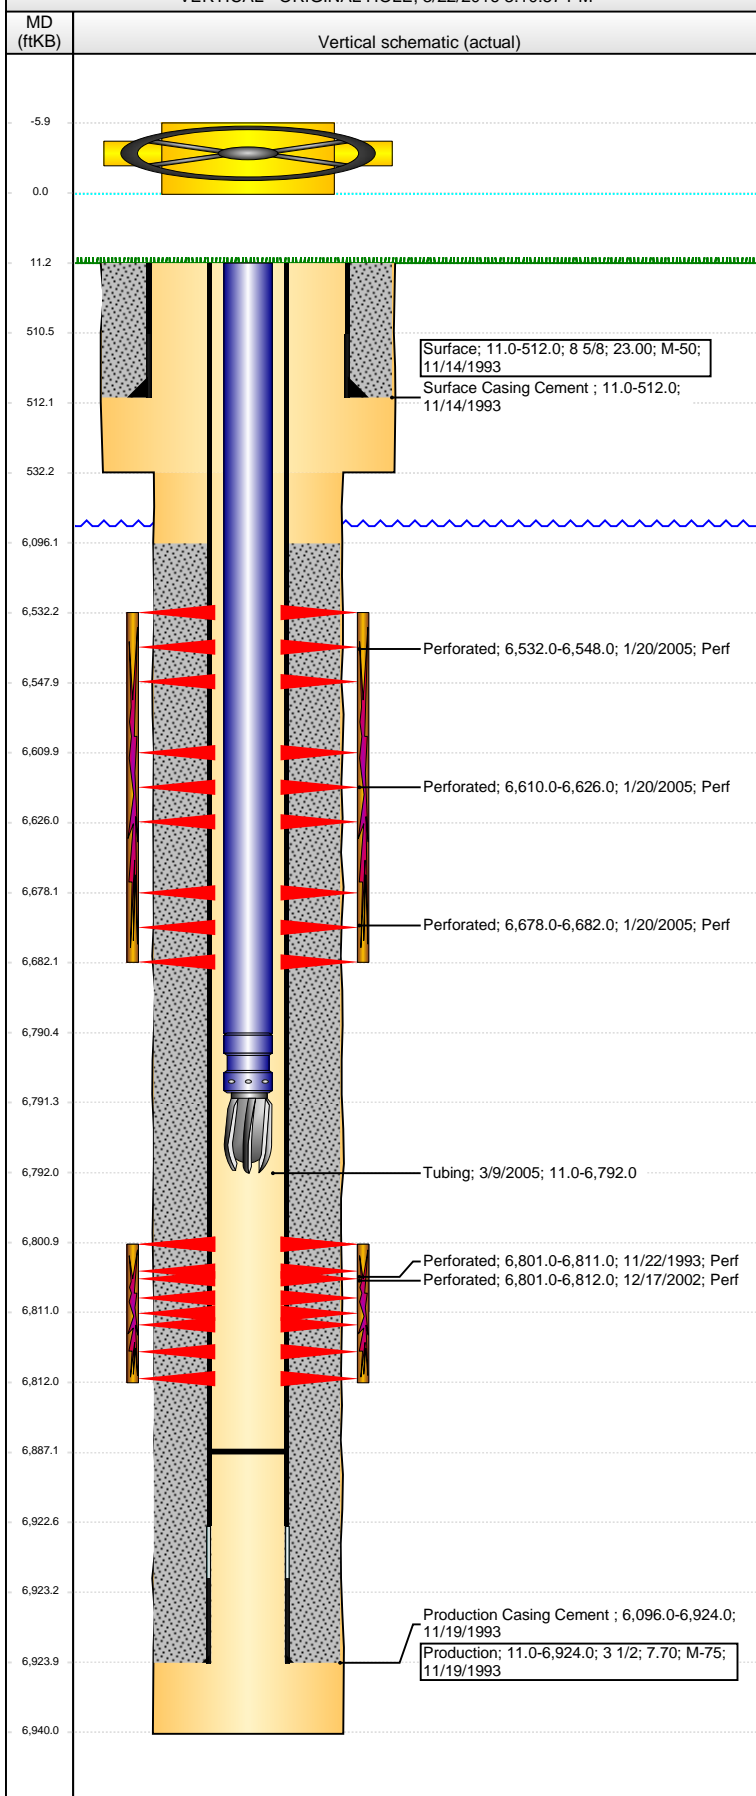


Well Name: ROHR 15-06

VERTICAL - ORIGINAL HOLE. 3/22/2016 3:10:57 PM

[illegible]

API 05-123-17604	Business Unit DJ BASIN	District 15	Well Config VERTICAL
Original KB Elevation (ft) 4.656	KB - GL / MSL (ftKB) 11.00	Spud Date 11/13/1993	P & A Date

Comment

Push CIBP to 6887 03/05

TD DISCREPANCY: ST RPT = 6935, DRL RPT & OPEN HOLE LOG = 6940

NO CBL FOR NEW DRILL JOB IN WELL FILE.

Directions To Well

Congressional Location
1000
1001
Quarter 1	Quarter 2	Quarter 3	Quarter 4	Section	Township	Twnshp N...	Range	Rng E/W Dir
		SE	NW	15	4	N	64	W

		-
Bottom Hole Location		

North-South Distance (ft)	From N or S Line	East-West Distance (ft)	From E or W Line
---------------------------	------------------	-------------------------	------------------

Plug Back Total Depths

Date	Depth (ftKB)	Method	Com
1/19/2005	6,886.0	CASED HOLE LOG	DEPTH LOGGER FROM CBL
3/9/2005	6,887.0	TAG	PUSH PLUG TO DEPTH

[illegible]

Section Des	Size (in)	Act Top, MD (ftKB)	Act Btm, MD (ftKB)
SURFACE	12 1/4	11.0	532.0
PRODUCTION	7 7/8	532.0	6,940.0

Zone Statuses

Zone Name	Status Date	Status	Fluid Type	Job	Prod Method
NIOBRARA	1/25/2005	PR	Oil	RECOMPLETI...	
NIOBRARA	3/10/2005	PR	Oil	RECOMPLETI...	
CODELL	12/4/1993	PR	Oil	DRILLING/CO...	
CODELL	12/31/2002	PR	Oil	RE-FRAC, 12/1...	
CODELL	3/10/2005	PR	Oil	RECOMPLETI...	

Casing Strings

Surface, 512.0ftKB						
Casing Description	Run Date	OD (in)	Wt/Len (l...	Grade	Top, MD (ft...	MD (ftKB)
Surface	11/14/1993	8 5/8	23.00	M-50	11.0	512.0

Production, 6,924.0ftKB

Casing Description	Run Date	OD (in)	Wt/Len (l...	Grade	Top, MD (ft...	MD (ftKB)
Production	11/19/1993	3 1/2	7.70	M-75	11.0	6.924.0

Cement

Description	Top Depth (ftKB)	Bottom Depth (ftKB)
Surface Casing Cement	11.0	512.0
Description	Top Depth (ftKB)	Bottom Depth (ftKB)
Production Casing Cement	6,096.0	6,924.0

Tubing Strings

Tubing Description	Run Date	String...	ID (in)	Wt (lb/ft)	Grade	Len (ft)	Set De...
Tubing	3/9/2005	2 1/16	1.751	3.25	J-55	6,781. 00	

Tubing Components

Item Des	OD (in)	Wt (lb/ft)	Grade	Jts	Len (ft)	Btm (ftKB)	Btm (TVD) (ftKB)
Tubing	2 1/16	3.25	J-55	206	6,779.20	6,790.2	
Pump Seating	2				1.00	6,791.2	
Nipple	1/16						
Blade Bit	2 1/16				0.80	6,792.0	

Perforation Data	
1	100%
2	100%
Zone	Brnch/St g	Entered Shot Total	Top (ftKB)	Btm (ftKB)	Date
NIOBRARA, ORIGINAL HOLE	A	96	6,532.00	6,548.00	1/20/2005
NIOBRARA, ORIGINAL HOLE	B	96	6,610.00	6,626.00	1/20/2005
NIOBRARA, ORIGINAL HOLE	B	24	6,678.00	6,682.00	1/20/2005
CODELL, ORIGINAL HOLE		20	6,801.00	6,811.00	11/22/1993
CODELL, ORIGINAL HOLE		44	6,801.00	6,812.00	12/17/2002

Well Name: ROHR 15-06

VERTICAL - ORIGINAL HOLE, 3/22/2016 3:10:59 PM

Stimulations & Treatments

Date 11/24/1993	Zone CODELL, ORIGINAL HOLE	Primary Job Type DRILLING/COMPLETION - ORIGINAL
Technical Result	Tech Result Details	Tech Result Note

Comment

Date 12/20/2002	Zone CODELL, ORIGINAL HOLE	Primary Job Type RE-FRAC
Technical Result	Tech Result Details	Tech Result Note

Comment

Date 1/24/2005	Zone NIOBRARA, ORIGINAL HOLE	Primary Job Type RECOMPLETION
Technical Result	Tech Result Details	Tech Result Note

Comment

Other In Hole

Run Date	Des	OD (in)	Top (ftKB)	Btm (ftKB)

Logs

Date	Type	Top, MD (ftKB)	Btm, MD (ftKB)
11/22/1993	DENSILOG	6,390.0	6,938.0
11/22/1993	GAMMA RAY	6,390.0	6,886.0
11/22/1993	INDUCTION	513.0	6,938.0
1/19/2005	CBL/CCL/GR	5,900.0	6,883.0

