


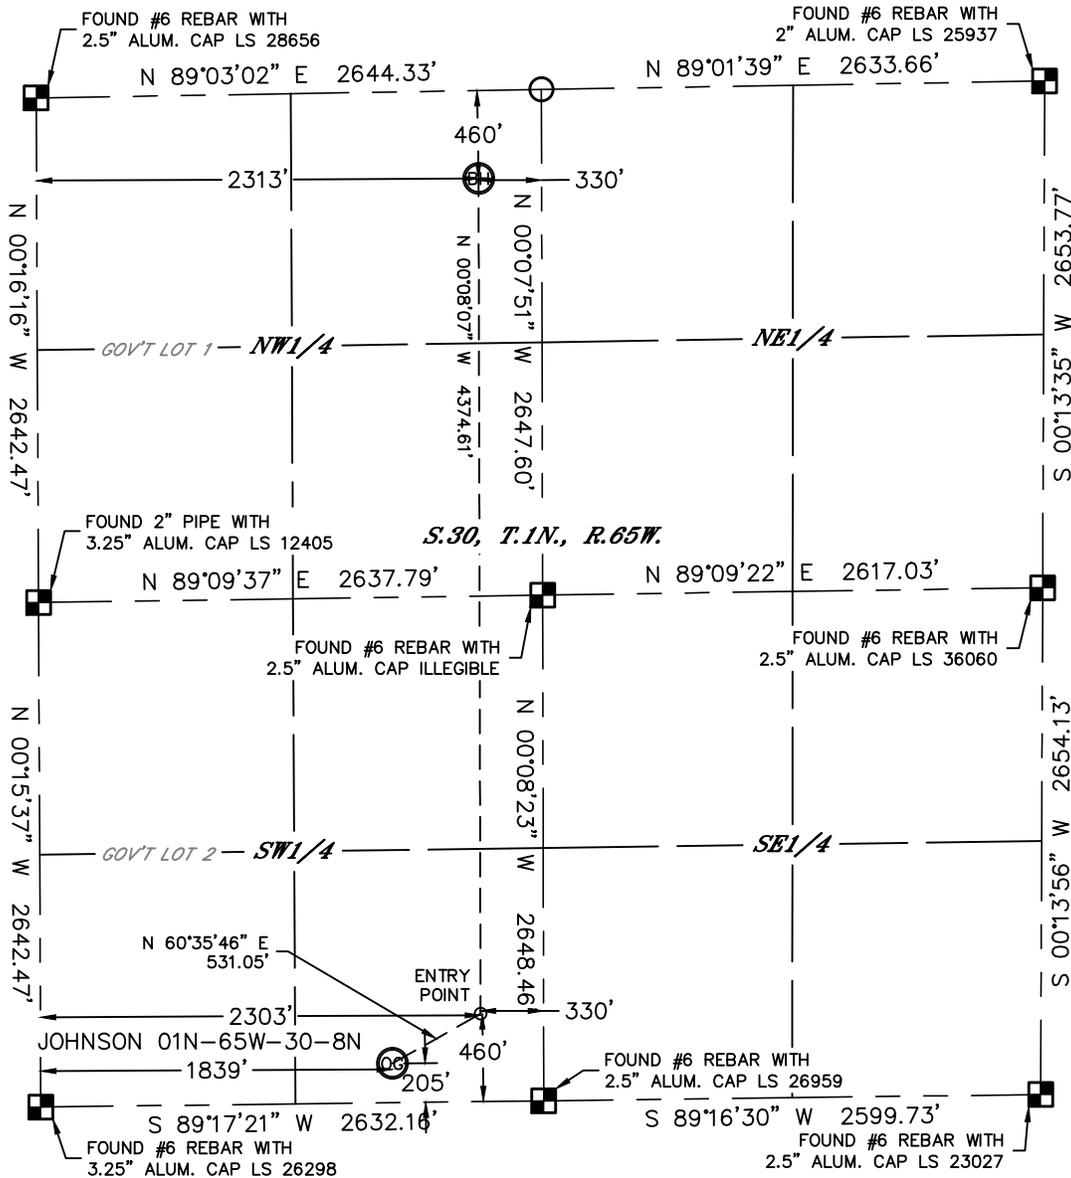

# WELL LOCATION CERTIFICATE


SECTION: 30  
TOWNSHIP: 1N  
RANGE: 65W

THIS MAP DOES NOT REPRESENT A BOUNDARY SURVEY



In accordance with a request from Arthur Beecher with VERDAD OIL & GAS CORPORATION Lat40°, Inc. has determined the surface location of the JOHNSON 01N-65W-30-8N to be 205' from the SOUTH line and 1839' from the WEST line and the bottom hole to be 460' from the NORTH line and 2313' from the WEST line as measured at right angles from the section lines of Section 30, Township 1 North, Range 65 West of the Sixth Principal Meridian, County of Weld, State of Colorado.


I hereby state that this Well Location Certificate was prepared by me, or under my direct supervision, that the fieldwork was completed on 6/17/2014, for and on behalf of VERDAD OIL & GAS COMPANY. That this is not a Land Survey Plat or an Improvement Survey Plat, and that it is not to be relied upon for establishment of fence, building, or other future improvement lines.

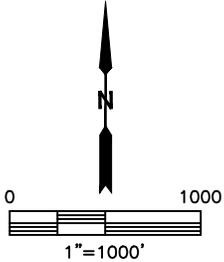

**SURFACE LOCATION**  
 LAT: 40.01562°N  
 LONG: 104.70958°W  
 PDOP: 1.4  
 ELEV: 4999'  
 1/4,1/4: SESW

**BOTTOM HOLE**  
 LAT: 40.02833°N  
 LONG: 104.70782°W

**ENTRY POINT**  
 LAT: 40.01632°N  
 LONG: 104.70792°W

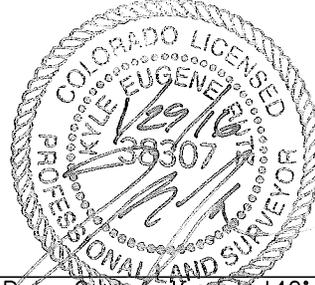

Kyle E. Rutz—On behalf of Lat40°, Inc.  
 Colorado Licensed Professional  
 Land Surveyor No. 38307

DATE: 1/29/2016  
 PROJECT#: 2014104

- NOTE:**
- 1) Bearings shown are Grid Bearings of the Colorado State Plane Coordinate System, North Zone, North American Datum 1983. The lineal dimensions as contained herein are based upon the "U.S. Survey Foot."
  - 2) Ground elevations are based on an observed GPS elevation (NAVD 1988 DATUM).
  - 3) IMPROVEMENTS: See LOCATION DRAWING for all visible improvements within 500' of disturbed area.
  - 4) SURFACE USE: CROPLAND
  - 5) INSTRUMENT OPERATOR: WYATT HALL
  - 6) NEAREST CULTURAL ITEMS:  
 BUILDING: 861' NE  
 BUILDING UNIT: 900' NE  
 HIGH OCCUPANCY BUILDING UNIT: +5280'  
 DESIGNATED OUTSIDE ACTIVITY AREA: +5280'  
 PUBLIC ROAD: 206' S (CR 4)  
 ABOVEGROUND UTILITY: 245' S  
 RAILROAD: ±2720' SE  
 PROPERTY LINE: 205' S

**LEGEND**



- = ALIQUOT MONUMENT AS DESCRIBED
- = CALCULATED POSITION



# SITE SKETCH

JOHNSON 01N-65W-30-8N

SECTION: 30  
TOWNSHIP: 1N  
RANGE: 65W

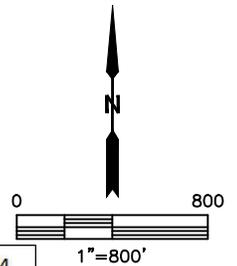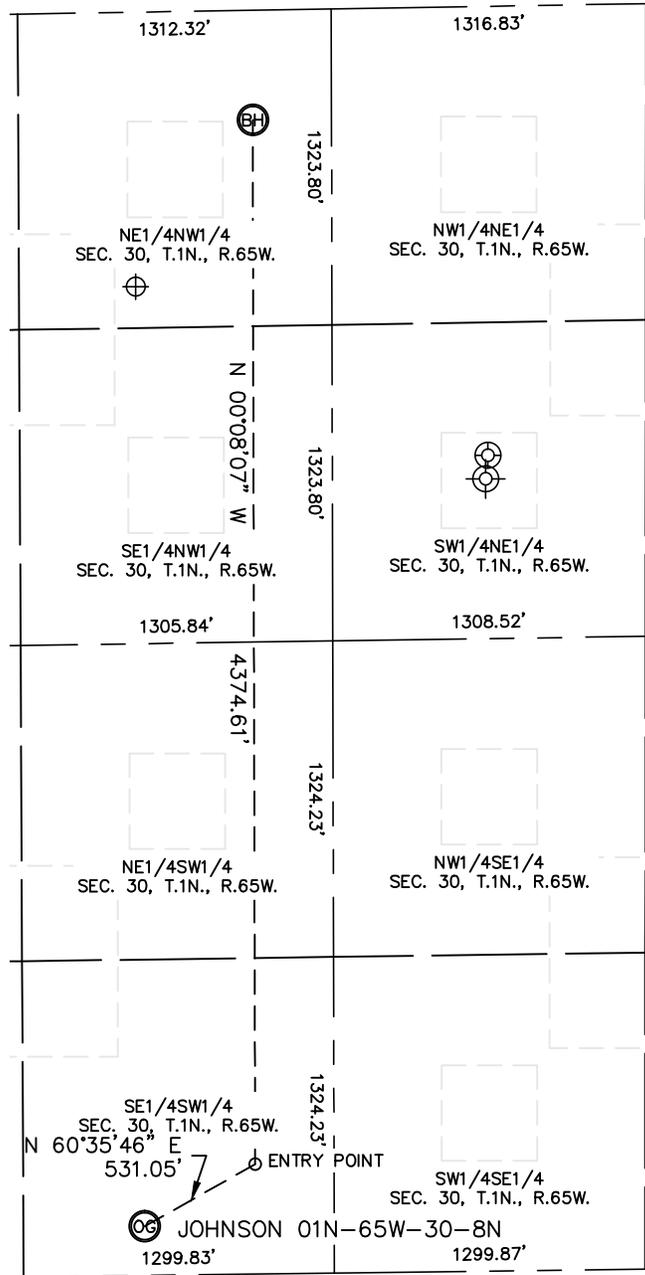

WELL NO.	WELL NAME	SHL FOOTAGE				SHL LAT°	SHL LONG°	PDOP	ELEV (FT.)	1/4/1/4
2	GILMORE 1-30	1150	FNL	1820	FWL	40.02644	-104.70961	N/A	4991	NENW
3	MARGUERITE B LEHLA-1	1881	FNL	1971	FEL	40.02445	-104.70435	2.0	4990	SWNE
4	M B LEHLA 1	1980	FNL	1980	FEL	40.02418	-104.70450	N/A	4984	SWNE

NOTE: THE ABANDONED WELL DATA SHOWN IN RED ABOVE WAS OBTAINED FROM COGCC SCOUT CARDS.

DATE: 1/29/2016  
PROJECT#: 2014104