


Well Name: STATE M36-17

VERTICAL - ORIGINAL HOLE, 4/4/2016 3:27:37 PM

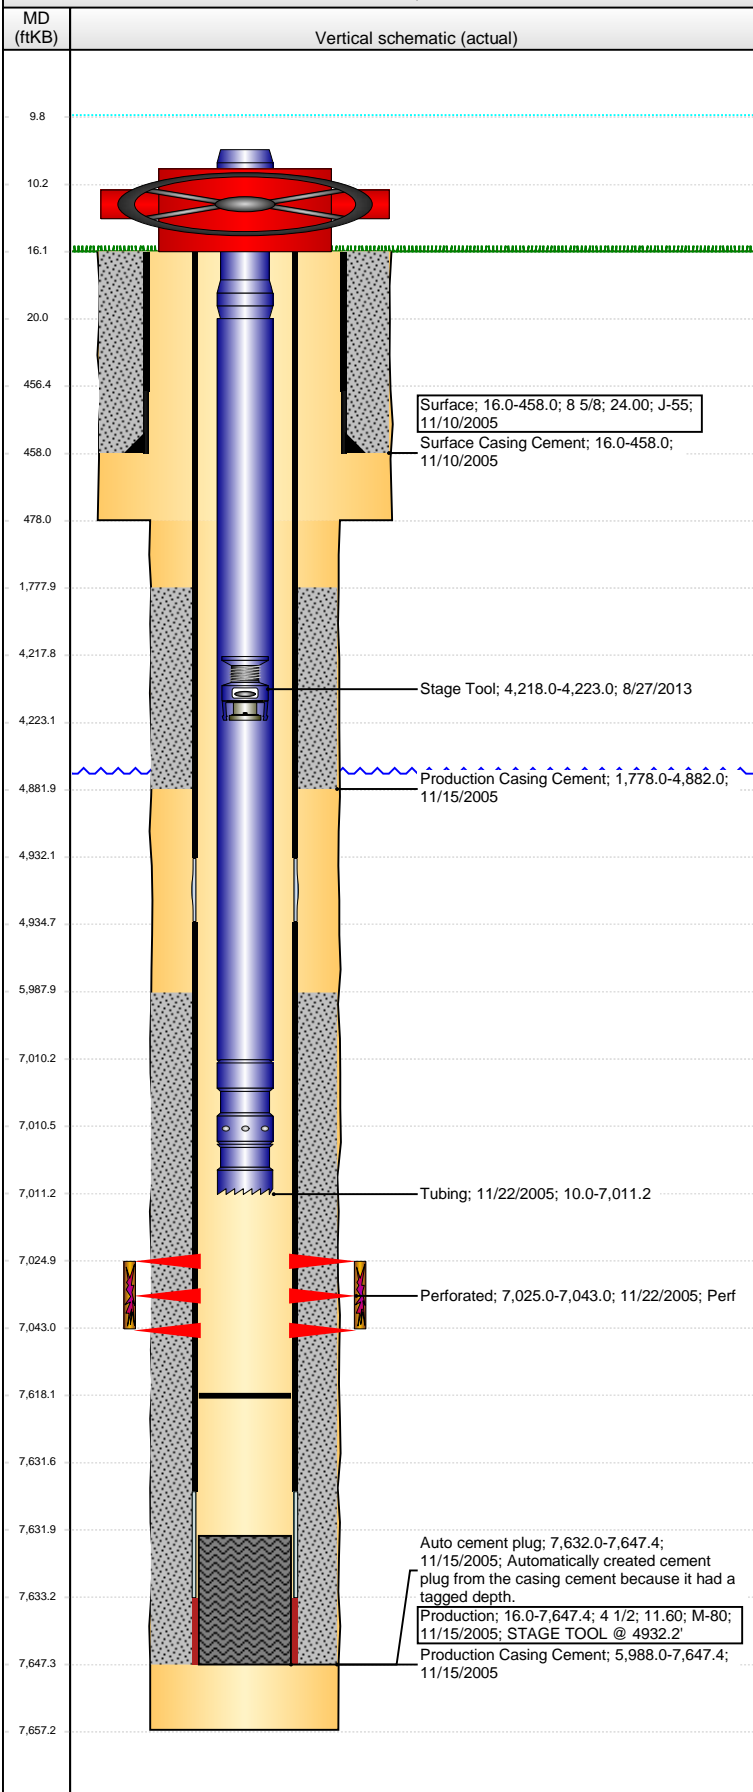

Well Header									
API 05-123-23221		Business Unit DJ BASIN		District 15		Well Config VERTICAL			
Original KB Elevation (ft) 4,734		KB - GL / MSL (ftKB) 16.00		Spud Date 11/10/2005		P & A Date			
Comment DV TOOL SET @ 4932'									
Directions To Well									
Congressional Location									
Quarter 1	Quarter 2	Quarter 3	Quarter 4	Section	Township	Twnshp N...	Range	Rng E/W Dir	
		SE	NE	36	6	N	67	W	
Bottom Hole Location									
North-South Distance (ft)		From N or S Line		East-West Distance (ft)			From E or W Line		
Plug Back Total Depths									
Date	Depth (ftKB)	Method			Com				
11/15/2005	7,632.0	CASING TALLY			TOP OF FLOAT COLLAR				
11/21/2005	7,619.0	TAG			TAG FILL				
11/22/2005	7,618.0	CASED HOLE LOG			DEPTH LOGGER ON CBL				
Wellbore Sections									
Section Des			Size (in)		Act Top, MD (ftKB)		Act Btm, MD (ftKB)		
SURFACE			12 1/4		16.0		478.0		
PRODUCTION			7 7/8		478.0		7,657.0		
Zone Statuses									
Zone Name	Status Date	Status	Fluid Type	Job	Prod Method				
CODELL	1/21/2006	PR		DRILLING/CO...					
Casing Strings									
Surface, 458.0ftKB									
Casing Description		Run Date	OD (in)	Wt/Len (l...	Grade	Top, MD (ft...	MD (ftKB)		
Surface		11/10/2005	8 5/8	24.00	J-55	16.0	458.0		
Production, 7,647.4ftKB									
Casing Description		Run Date	OD (in)	Wt/Len (l...	Grade	Top, MD (ft...	MD (ftKB)		
Production		11/15/2005	4 1/2	11.60	M-80	16.0	7,647.4		
Cement									
Description					Top Depth (ftKB)		Bottom Depth (ftKB)		
Surface Casing Cement					16.0		458.0		
Description					Top Depth (ftKB)		Bottom Depth (ftKB)		
Production Casing Cement					1,778.0		4,882.0		
Description					Top Depth (ftKB)		Bottom Depth (ftKB)		
Production Casing Cement					5,988.0		7,647.4		
Tubing Strings									
Tubing Description		Run Date	String...	ID (in)	Wt (lb/ft)	Grade	Len (ft)	Set De...	
Tubing		11/22/2005	2 3/8	1.995	4.70	J-55	7,001.16		
Tubing Components									
Item Des		OD (in)	Wt (lb/ft)	Grade	Jts	Len (ft)	Btm (ftKB)	Btm (TVD) (ftKB)	
Pup Joint		2 3/8		J-55	1	10.00	20.0		
EUE 8rd Tubing		2 3/8	4.70	J-55	212	6,990.16	7,010.2		
Seal Nipple		2 3/8				0.50	7,010.7		
Notched collar		2 3/8				0.50	7,011.2		
Perforation Data									
Zone		Bnch/St g	Entered Shot Total	Top (ftKB)		Btm (ftKB)		Date	
CODELL, ORIGINAL HOLE			72	7,025.00		7,043.00		11/22/2005	
Stimulations & Treatments									
Date	Zone			Primary Job Type					
1/18/2006	CODELL, ORIGINAL HOLE			DRILLING/COMPLETION - ORIGINAL					
Technical Result			Tech Result Details				Tech Result Note		
Comment									
Other In Hole									
Run Date		Des			OD (in)	Top (ftKB)	Btm (ftKB)		
8/27/2013		Stage Tool			2	4,218.0	4,223.0		
Logs									
Date	Type					Top, MD (ftKB)	Btm, MD (ftKB)		
11/14/2005	COMPENSATED DENSITY					2,350.0	7,636.0		
11/14/2005	INDUCTION					458.0	7,656.0		

Well Name: STATE M36-17

VERTICAL - ORIGINAL HOLE, 4/4/2016 3:27:39 PM

Logs

