

# WELLBORE DIAGRAM

Original WBD

656' FSL & 2140' FEL

Operator: Great Western

Well Name: Detterer 34-24

Lease Number:

Location: SWSE Sec. 24 T6N R67W


Field: Wattenberg

County, State: Weld, CO

API Number: 05-123-24706

Diagram Date: 4/4/2016

12 1/4" Hole  
8 5/8" 24# csg set at 582'  
Cmt'd w/ 450sks  
TOC: Surface

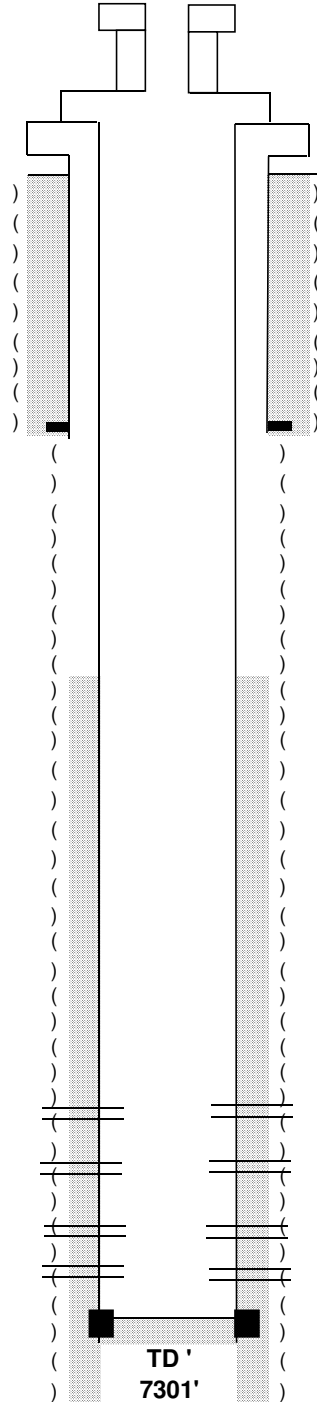

## Well History

Spud Date: 5/1/2007  
Date TD Reached: 5/7/2007  
Completion Date: 5/7/2007

Deepest Offset water well: 480'

Base Upper Pierre: 1125'  
Parkman Top: 3492'  
Sussex: 4192'  
Niobrara: 6775'  
Fort Hays: 7078'  
Codell: 7100'

7 7/8" Prod hole  
4 1/2" # 11.6 csg set @7272'  
Cmt'd w/ 580sks  
Cmt top: 3583'