


LOCATION DRAWING  
NATIONAL HOG FARMS 24-21 PRODUCTION FACILITY

SECTION: 21  
TOWNSHIP: 5N  
RANGE: 63W

IMPROVEMENTS:

(MEASURED FROM THE NATIONAL HOG FARMS 24-21 REFERENCE POINT)

- Ⓟ NO BUILDING UNITS WITHIN 500' IMPROVEMENT BUFFER
- Ⓛ NO BUILDINGS WITHIN 500' IMPROVEMENT BUFFER
- ① FENCE 547' S
- ② ACCESS ROAD 79' W
- ③ PRIVATE ROAD 514' S
- ④ WET AREA 58' SE, 82' W, 593' S

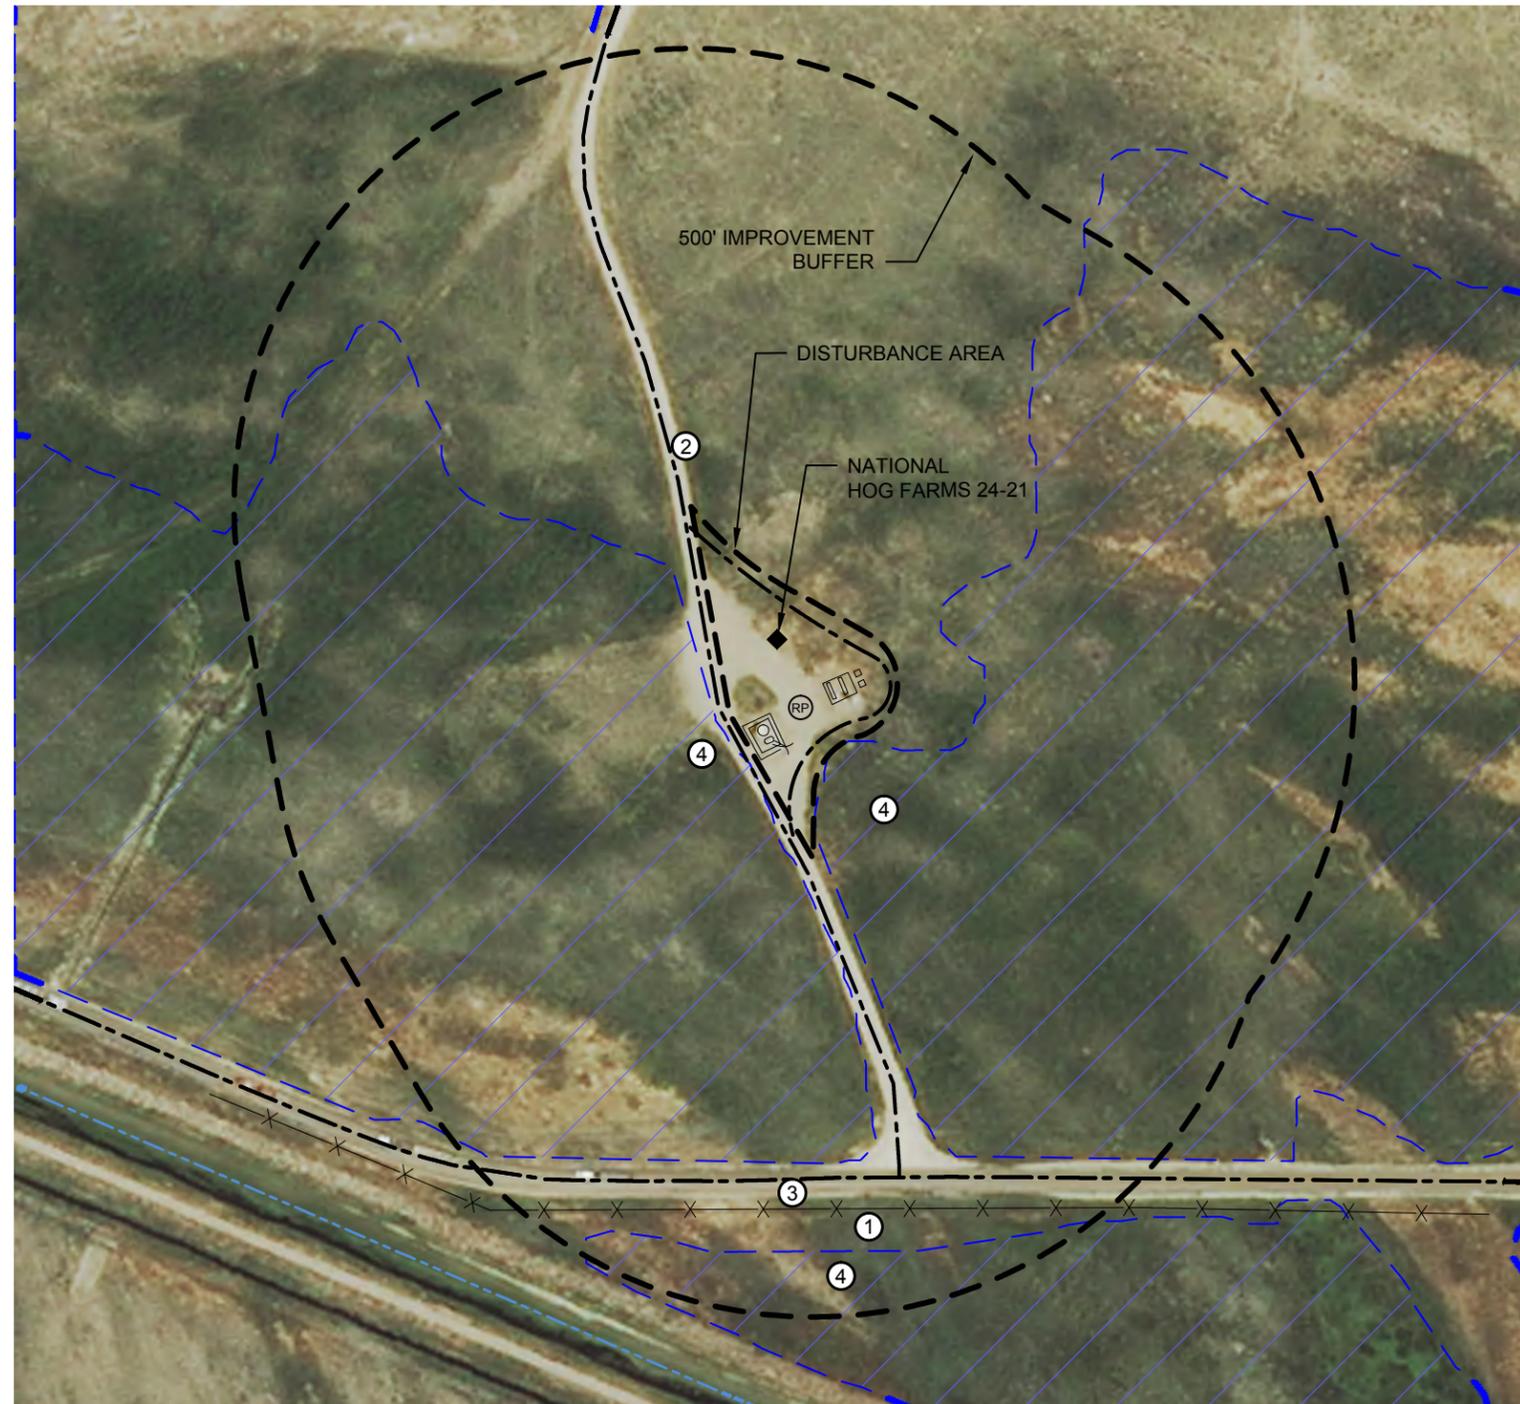

FACILITY REFERENCE POINT  
 LATITUDE: 40.37924°N  
 LONGITUDE: 104.44253°W  
 ELEVATION: 4543'  
 PDOP: 1.5  
 OPERATOR: SPENCER BURNS  
 ¼ ¼: SE ¼ SW ¼  
 FSL: ± 612'  
 FWL: ± 2268'  
 ASSOCIATED NEW WELLS:  
 NONE  
 ASSOCIATED EXISTING WELLS:  
 NATIONAL HOG FARMS 24-21

FIELD DATE: 01-11-16  
 DRAWING DATE: 03-08-16  
 DRAWN BY: KAD  
 CHECKED BY: MDC

| MEASURED FROM THE NEAREST | BUILDING | BUILDING UNIT | HIGH OCCUPANCY BUILDING UNIT | DESIGNATED OUTSIDE ACTIVITY AREA | PUBLIC ROAD         | ABOVE GROUND UTILITY | RAILROAD | PROPERTY LINE |
|---------------------------|----------|---------------|------------------------------|----------------------------------|---------------------|----------------------|----------|---------------|
| EDGE OF DISTURBANCE       | 2843' E  | 2896' E       | 5280'+                       | 5280'+                           | 5280'+ (CO HWY 388) | 3399' E              | 5280'+   | 447' S        |
| WELLHEAD                  | 2965' NE | 3020' NE      | 5280'+                       | 5280'+                           | 5280'+ (CO HWY 388) | 3529' E              | 5280'+   | 686' S        |

