


North
↑

Republican Water Collection County Road 30 & U-Line Leak 4-22-16

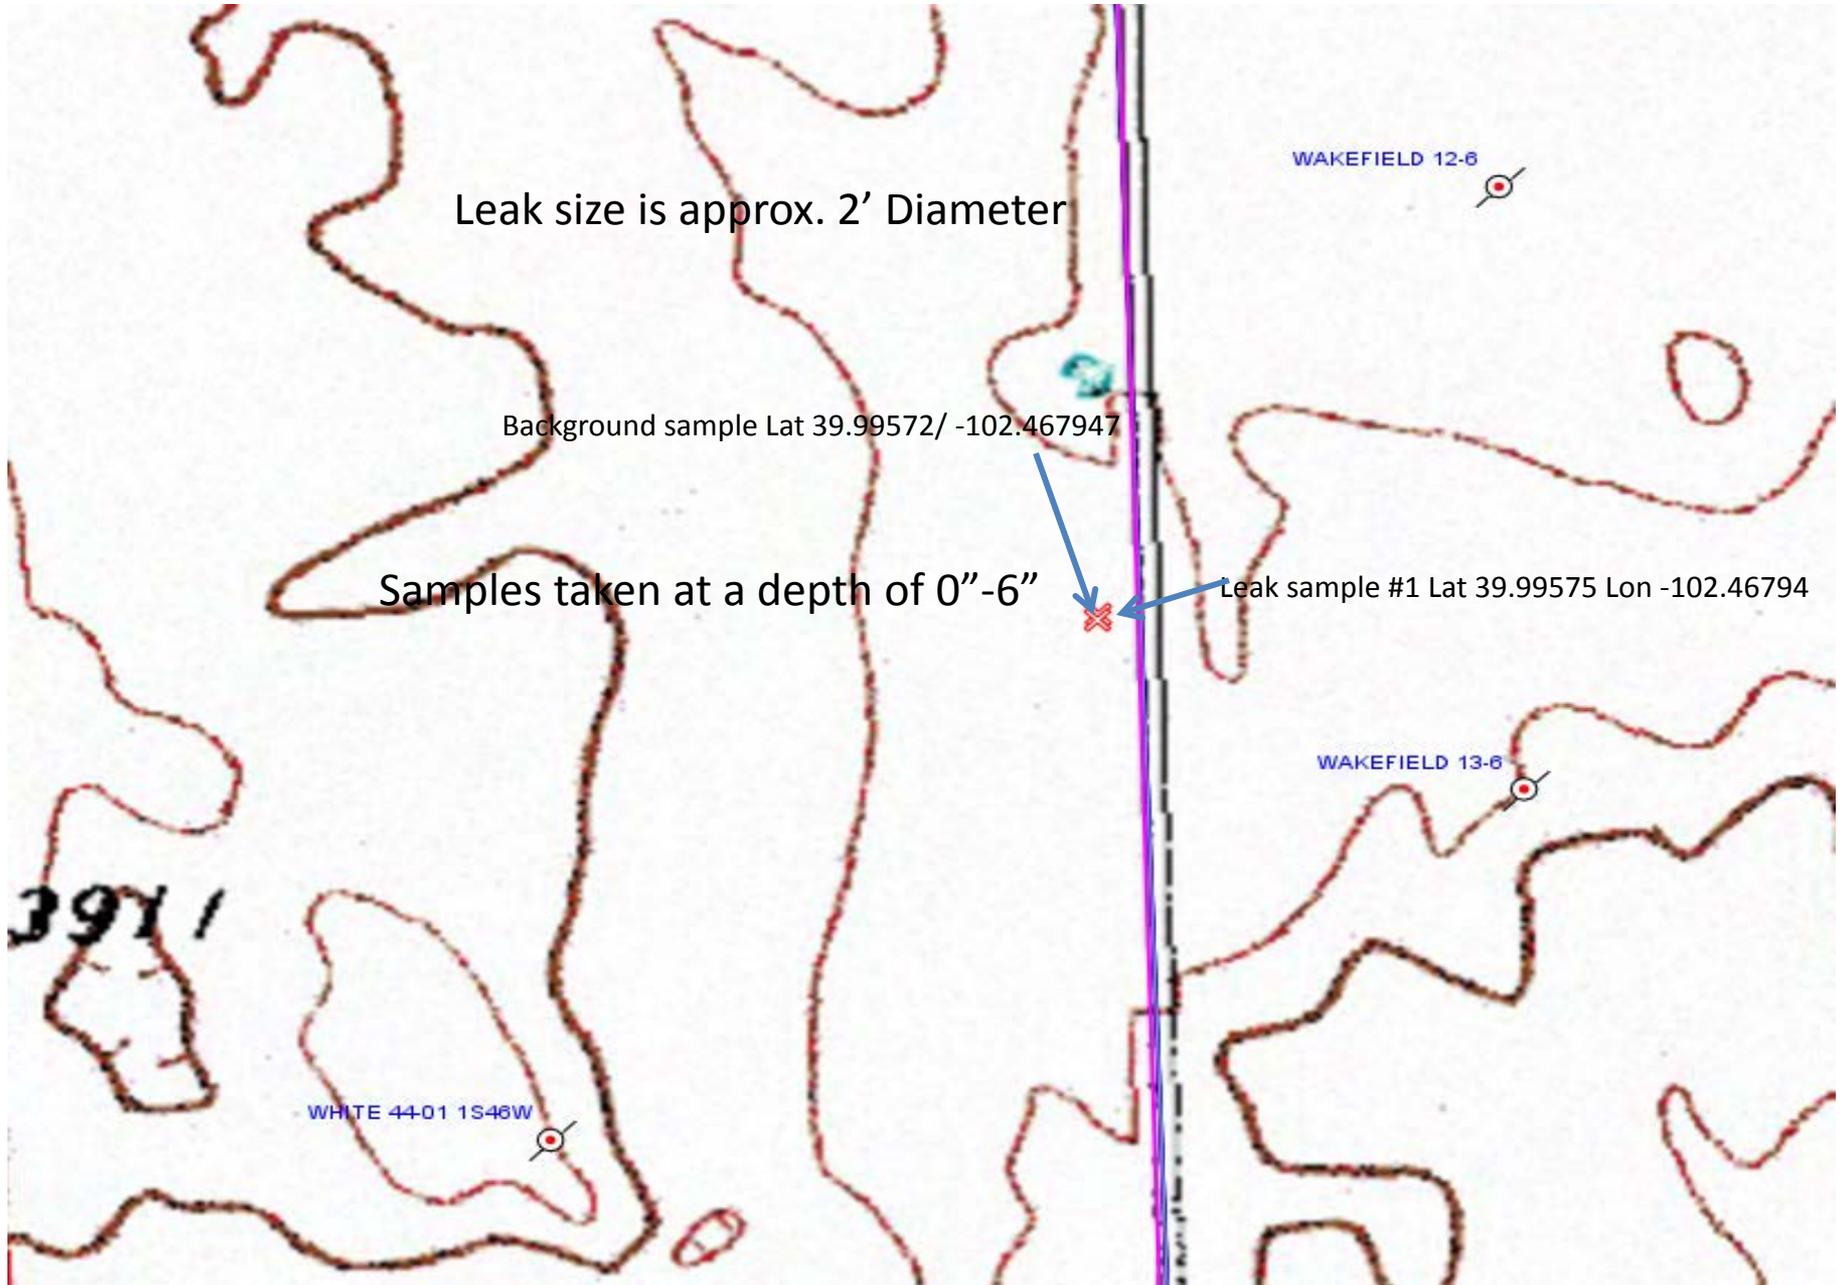

North
↑

Republican Water Collection County Road 30 & U-Line Leak 4-22-16

