

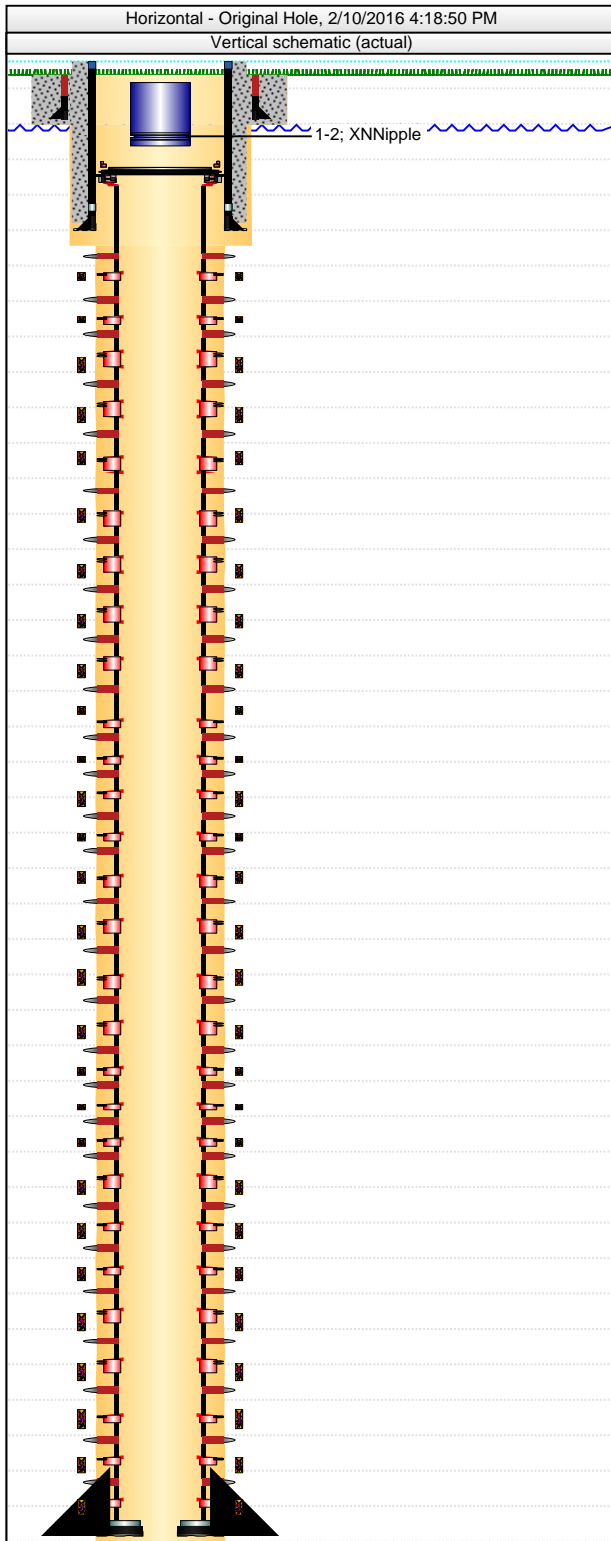
## Downhole Well Profile

**Well Name: Walton J-25HN**

API/UWI 05-123-41417	Surface Legal Location Section 25-T7N-R67W	Field Name Wattenberg	License #	State/Province Colorado	Well Configuration Type Horizontal
Original KB Elevation (ft) 5,001.00	KB-Tubing Head Distance (ft)	Spud Date 7/17/2015 00:00	Rig Release Date	PBTD (All)	Total Depth All (TVD)

**Wellhead and Christmas Tree Systems**

Type	Make	Service	Working Pressure (psi)	Max Pres (psi)	Size (in)
------	------	---------	------------------------	----------------	-----------


**Casing Strings**

Csg Des	OD (in)	Wt/Len (lb/ft)	Grade	Top Thread	Set Depth (ftKB)
Surface	9 5/8	36.00	J-55		782.8
Intermediate	7	26.00	P-110	Buttress Thread	7,828.5
Production	4 1/2	11.60	P-110	BTC	12,217.0

**Perforations**

Date	Top (ftKB)	Btm (ftKB)	Linked Zone
	8,024.0	8,027.9	
	8,208.9	8,212.8	
	8,351.7	8,355.6	
	8,494.7	8,498.6	
	8,637.4	8,641.4	
	8,823.4	8,827.3	
	8,966.5	8,970.4	
	9,109.6	9,113.5	
	9,252.7	9,256.6	
	9,437.9	9,441.8	
	9,581.0	9,584.9	
	9,724.0	9,727.9	
	9,867.1	9,871.0	
	10,010.4	10,014.3	
	10,194.6	10,198.5	
	10,337.3	10,341.3	
	10,479.8	10,483.7	
	10,621.1	10,625.1	
	10,806.1	10,810.0	
	10,949.1	10,953.0	
	11,089.7	11,092.9	
	11,232.0	11,235.2	
	11,415.9	11,419.1	
	11,557.8	11,561.0	
	11,699.6	11,702.8	
	11,841.3	11,844.5	
	12,025.8	12,029.0	
	12,168.1	12,171.2	

**Tubing Strings**

Tubing Description		Run Date		String Length (ft)		Set Depth (ftKB)	
Tubing - Production		1/22/2016		7,036.99		7,060.0	
Item Des	Jts	Make	Model	OD (in)	Wt (lb/ft)	Grade	Len (ft)
Tubing	21			2 7/8	6.50	L-80	7,001
	4						.79
XNNipple	1			2 7/8	6.50	L-80	1.10
Tubing	1			2 7/8	6.50	L-80	32.70
Ceramic disc sub	1						1.40

**Rod Strings**

Rod Description		Run Date		String Length (ft)		Set Depth (ftKB)	
Item Des	Jts	Make	Model	OD (in)	Wt (lb/ft)	Grade	Len (ft)