WELLBORE SCHEMATIC

PROPOSED

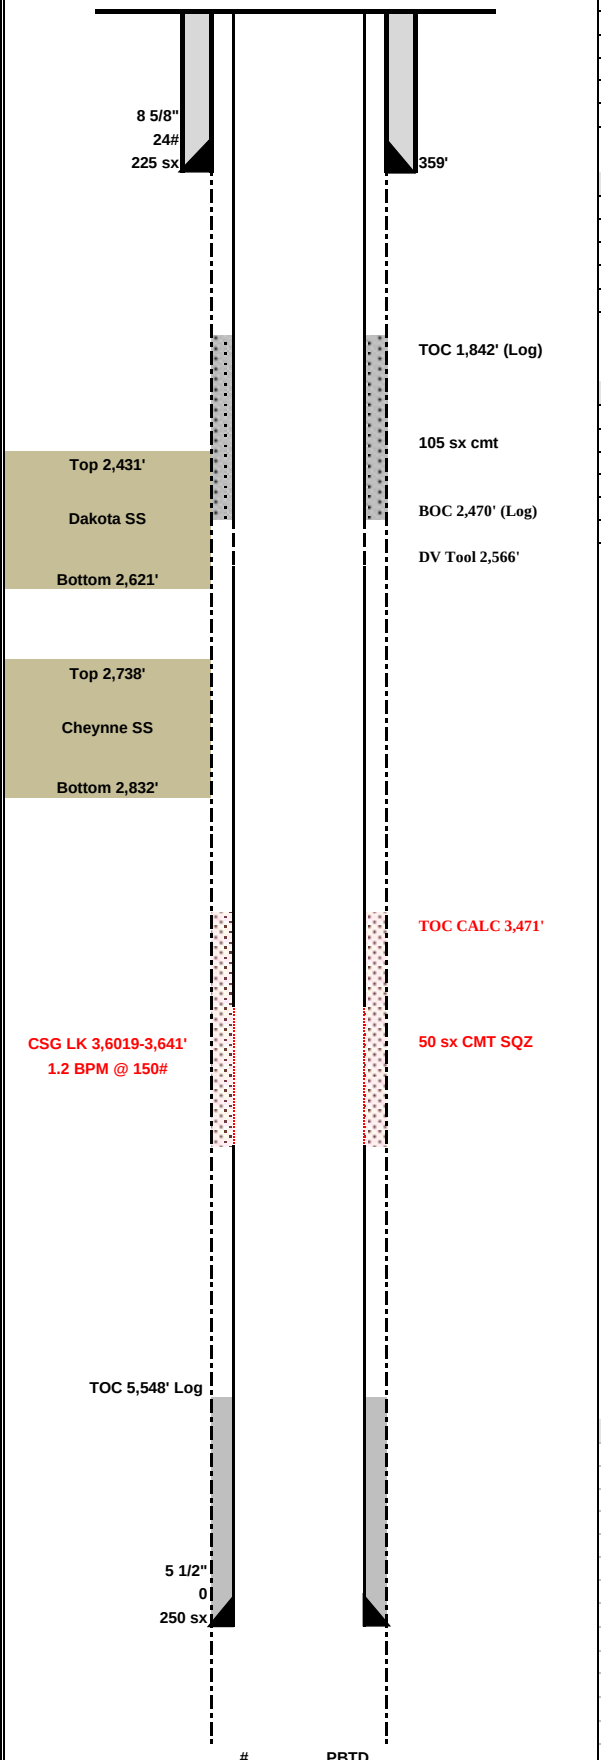

Citation Oil & Gas Corp.

Lease:	**Bledsoe Ranch**			Well No.	**#9 13-31**
API No.	05-017-07208			Status	IJ
Location:	NWSW 31 12S 50W 6 PM				
County:	Cheyenne	State:	CO	Field:	Bledsoe Ranch
TD	6601'	GL	4760'	Spud Date:	3/4/98
PBTD	5249'	KB	4770'	Comp Date:	4/1/98
Current Perfs/OH:	6,512-6,601'			Current Zone:	Arbuckle

Surface Equipment

Unit Make:		Unit Size:	
Unit S/N:		Unit Rotation:	
SPM:	Stroke Length:	Unit Sheave:	
Prime Mover:		Motor Sheave:	
Motor S/N:		Motor RPM:	

Casing Breakdown

	Size	Grade / Wt	Depth	Cement
Surface	8 5/8"	24#	359'	225 sx
Production (DV Tool)	5 1/2"		2,566'	105 sx
Production	5 1/2"	15.5#	6512'	250 sx
Open Hole	7 7/8"		6,512'-6,601'	

Current Completion Assembly

Qty	Description	Footage
	TOTAL	**0.00'**

Rod Detail

Qty	Description	Footage
	TOTAL	**0.00'**

Comments

PREPARED BY:	LL	UPDATED:	4/26/2016