





Lat40°, Inc. 6250 W. 10th Street, Unit 2, Greeley, CO 970-515-5294

LOCATION DRAWING

HIGH POINTE LLC 5N67W10L PAD

SECTION: 10
TOWNSHIP: 5N
RANGE: 67W
6TH. P.M.
WELD COUNTY, CO

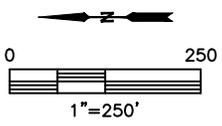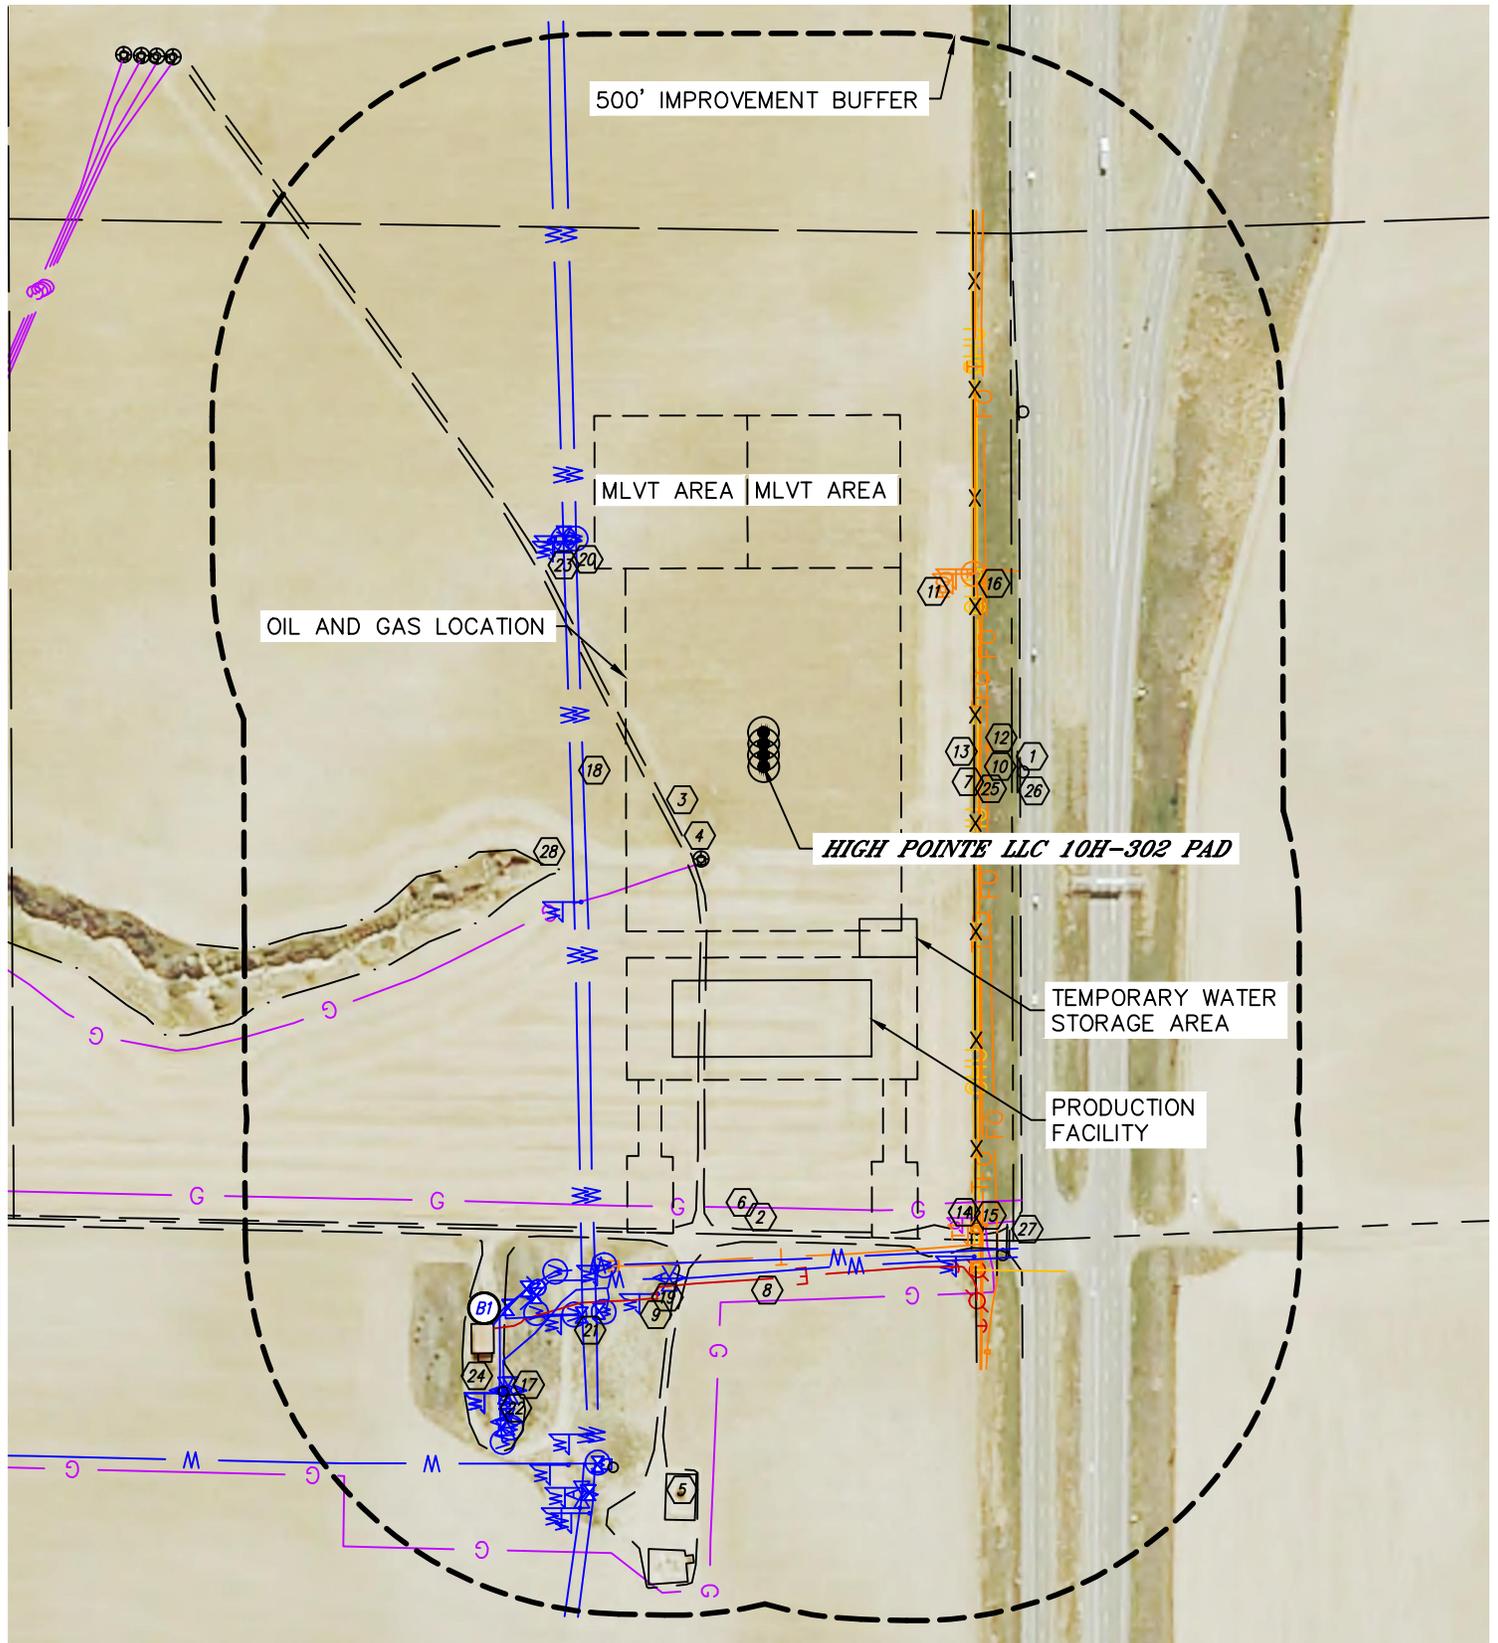



Lat40°, Inc. 6250 W. 10th Street, Unit 2, Greeley, CO 970-515-5294

LOCATION DRAWING

HIGH POINTE LLC 5N67W10L PAD

SECTION: 10
TOWNSHIP: 5N
RANGE: 67W
6TH. P.M.
WELD COUNTY, CO

IMPROVEMENTS:
(MEASURED FROM THE PROPOSED HIGH POINTE LLC 10H-302 WELL LOCATION)

- ① NO BUILDING UNITS WITHIN 500' IMPROVEMENT BUFFER
- ② BUILDING B1 810' NW
- ③ HIGHWAY 34 336' S
- ④ 131ST AVENUE 607' W
- ⑤ ROAD 136', 634' & 693' NW
- ⑥ EX. WELL HEAD 146' NW
- ⑦ EX. PRODUCTION EQUIPMENT 931' & 1031' NW (PDC ENERGY)
- ⑧ GAS LINE LOCATES ±577' W (DCP), ±155' NW (PDC ENERGY), ±699' W (KERR MCGEE)
- ⑨ OVERHEAD UTILITY LINE 275' S
- ⑩ ELECTRIC LINE LOCATES ±669' W
- ⑪ ELECTRIC PANEL 704' NW
- ⑫ FIBER OPTIC LINE LOCATES ±283' & ±293' S
- ⑬ FIBER OPTIC MARKER 371' & 378' SE
- ⑭ FIBER OPTIC VAULT 391' S, 817' SW
- ⑮ TELEPHONE LINE LOCATES ±282' S, ±644' W
- ⑯ TELEPHONE MARKER 667' SW
- ⑰ TELEPHONE PEDESTAL 664', 711' & 713' SW, 681' NW
- ⑱ TELEPHONE MANHOLE 373' SE
- ⑲ COMMUNICATION TOWER 886' & 938' NW
- ⑳ WATER LINE LOCATES ±236' & ±253' N, ±646' & ±680' W, ±712' & ±939' NW
- ㉑ WATER MAKER 297', 681', 704', 757', 889', 904', 949', 973', 1000' & 1004' NW, 388' & 392' NE, 698' SW
- ㉒ WATER MANHOLE 387' & 397' NE, 685', 715', 743', 744', 759', 767', 926', 937' & 947' NW
- ㉓ WATER VALVE 745', 750', 751', 754', 756', 783', 931' & 939' NW
- ㉔ WATER VAULT 885', 891', 897', 903', 909' & 928' NW
- ㉕ AIR VALVE 396' NE, 680', 881', 884', 921' & 982' NW
- ㉖ CONCRETE STRUCTURE 844' NW
- ㉗ FENCE 276' S
- ㉘ SIGN 340' S, 571' SE, 663' & 708' SW
- ㉙ PIPE 679' SW
- ㉚ RAVINE 294' NW