


Wellbore Schematic Input Report

Well Name: STROHAUER 18-21

VERTICAL - ORIGINAL HOLE, 5/11/2016 2:27:54 PM

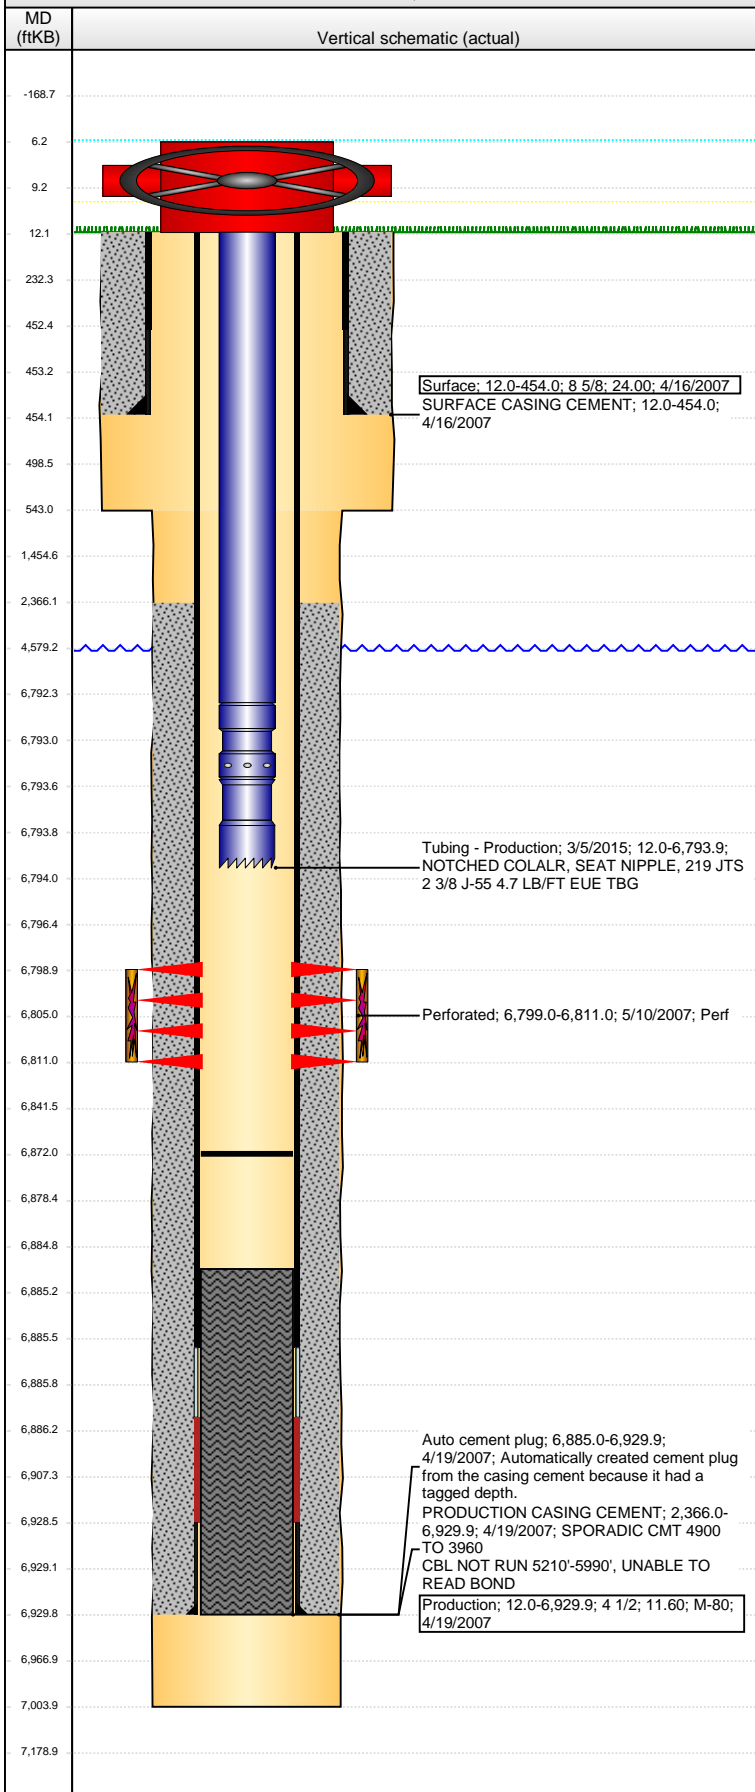

Well Header									
API 05-123-23807		Business Unit DJ BASIN		District 15		Well Config VERTICAL			
Original KB Elevation (ft) 4,675		KB - GL / MSL (ftKB) 12.00		Spud Date 4/15/2007		P & A Date			
Comment									
Directions To Well WCR 61 & 70, EAST 1/4, SOUTH 1/4, EAST 1/10 INTO.									
Congressional Location									
Quarter 1	Quarter 2 SW	Quarter 3 NE	Quarter 4 NW	Section 18	Township 6 N	Twnshp N...	Range 63	Rng E/W Dir W	
Bottom Hole Location									
North-South Distance (ft)		From N or S Line		East-West Distance (ft)			From E or W Line		
Plug Back Total Depths									
Date	Depth (ftKB)	Method			Com				
4/19/2007	6,885.6	TAG			FLOAT SHOE W/ BAFFLE				
5/8/2007	6,878.0	CASED HOLE LOG			DEPTH LOGGER ON CBL				
9/11/2007	6,880.0	TAG			CLEAN OUT TO LAND TUBING				
3/2/2015	6,872.0	TAG 23' IN ON 222			61' OF RAT HOLE DID NOT C/O				
Wellbore Sections									
Section Des			Size (in)		Act Top, MD (ftKB)		Act Btm, MD (ftKB)		
SURFACE			12 1/4		12.0		543.0		
PRODUCTION			7 7/8		543.0		7,004.0		
Zone Statuses									
Zone Name	Status Date	Status	Fluid Type	Job	Prod Method				
CODELL	6/29/2007	PR		DRILLING/CO...					
Casing Strings									
Surface, 454.0ftKB									
Casing Description Surface	Run Date 4/16/2007	OD (in) 8 5/8	Wt/Len (l... 24.00	Grade	Top, MD (ft... 12.0	MD (ftKB) 454.0			
Production, 6,929.9ftKB									
Casing Description Production	Run Date 4/19/2007	OD (in) 4 1/2	Wt/Len (l... 11.60	Grade M-80	Top, MD (ft... 12.0	MD (ftKB) 6,929.9			
Cement									
Description SURFACE CASING CEMENT				Top Depth (ftKB) 12.0		Bottom Depth (ftKB) 454.0			
Description PRODUCTION CASING CEMENT				Top Depth (ftKB) 2,366.0		Bottom Depth (ftKB) 6,929.9			
Tubing Strings									
Tubing Description Tubing	Run Date 9/11/2007	String... 2 3/8	ID (in)	Wt (lb/ft)	Grade	Len (ft) 6,758.00	Set De...		
Tubing Description Tubing - Production	Run Date 3/5/2015	String... 2 3/8	ID (in) 1.995	Wt (lb/ft) 4.70	Grade J-55	Len (ft) 6,781.92	Set De...		
Tubing Components									
Item Des	OD (in)	Wt (lb/ft)	Grade	Jts	Len (ft)	Btm (ftKB)	Btm (TVD) (ftKB)		
EUE 8rd Tubing	2 3/8	4.70	J-55	219	6,780.42	6,792.4			
Pump Seating Nipple	2 3/8			1	1.10	6,793.5			
Notched collar	2 3/8			1	0.40	6,793.9			
Perforation Data									
Zone	Bnch/St g	Entered Shot Total	Top (ftKB)		Btm (ftKB)		Date		
CODELL, ORIGINAL HOLE		48	6,799.00		6,811.00		5/10/2007		
Stimulations & Treatments									
Date 5/11/2007	Zone CODELL, ORIGINAL HOLE			Primary Job Type DRILLING/COMPLETION - ORIGINAL					
Technical Result		Tech Result Details				Tech Result Note			
Comment									
Other In Hole									
Run Date	Des				OD (in)	Top (ftKB)	Btm (ftKB)		

Well Name: STROHAUER 18-21

VERTICAL - ORIGINAL HOLE, 5/11/2016 2:27:56 PM

Logs

Date	Type	Top, MD (ftKB)	Btm, MD (ftKB)
4/18/2007	COMPENSATED DENSITY	3,450.0	6,951.0
4/18/2007	INDUCTION	452.0	6,971.0
5/8/2007	CBL/CCL/GR	2,300.0	6,876.0

