WELLBORE SCHEMATIC

CURRENT

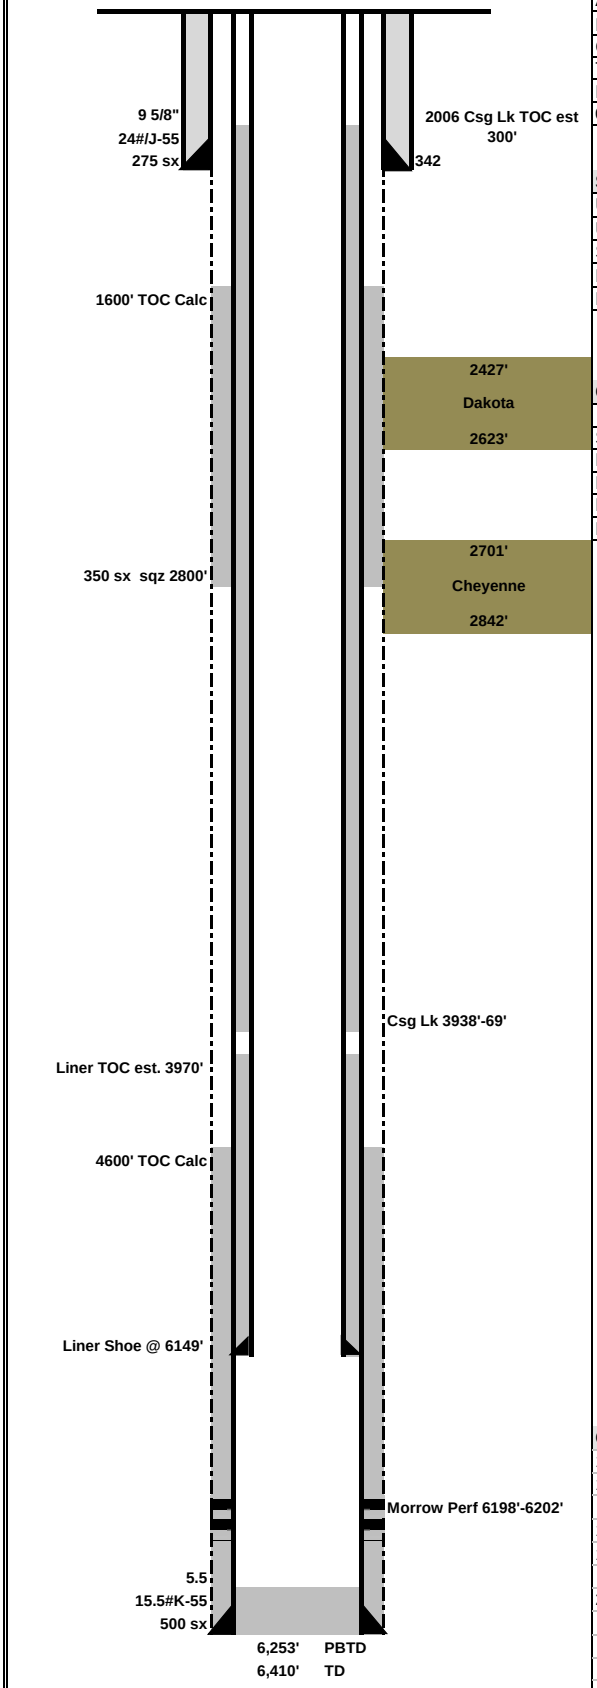

Citation Oil & Gas Corp.

Lease:	**Williams**			Well No.	**#1**
API No.	05-01706676			Status	PR
Location:	NE/SW Sec. 11 T13S R51W				
County:	Cheyenne	State:	CO	Field:	Castle Peak
TD	6410'	GL	4805'	Spud Date:	8/14/87
PBTD	6253'	KB	4815'	Comp Date:	9/1/87
Current Perfs/OH:	6198'-6202'	Current Zone:		Morrow	

Surface Equipment

Unit Make:		Unit Size:	
Unit S/N:		Unit Rotation:	
SPM:	Stroke Length:	Unit Sheave:	
Prime Mover:		Motor Sheave:	
Motor S/N:		Motor RPM:	

Casing Breakdown

	Size	Grade / Wt	Depth	Cement
Surface	9 5/8"	24#/J-55	342'	275 sx
Production	5 1/2	15.5#K-55	6410'	500 sx
Liner	4	10.5#/J-55	6149	100sx
Liner				
Liner				

Current Completion Assembly

Qty	Description	Footage
	TOTAL	**0.00'**

Rod Detail

Qty	Description	Footage
	TOTAL	**0.00'**

Comments

1987 Surf ran to 342' cemented w/ 275 sx
1987 Prod 51/2" ran to 6410' cemented with 500 sx, TOC est at 4600'

1996 Daktoa/Cheyenne Sqz Perf 2800'-01' Sqz'ed w/ 350 sx cmt, TOC est 1580'
1996 4" liner ran to 6149' cemented with 100 sx, TOC est 3970'

2006 Casing Leak 3938'-3969', squeezed with 300 sx cement, TOC Est 300'

PREPARED BY:	LL	UPDATED:	5/16/2016