


Retention Pond

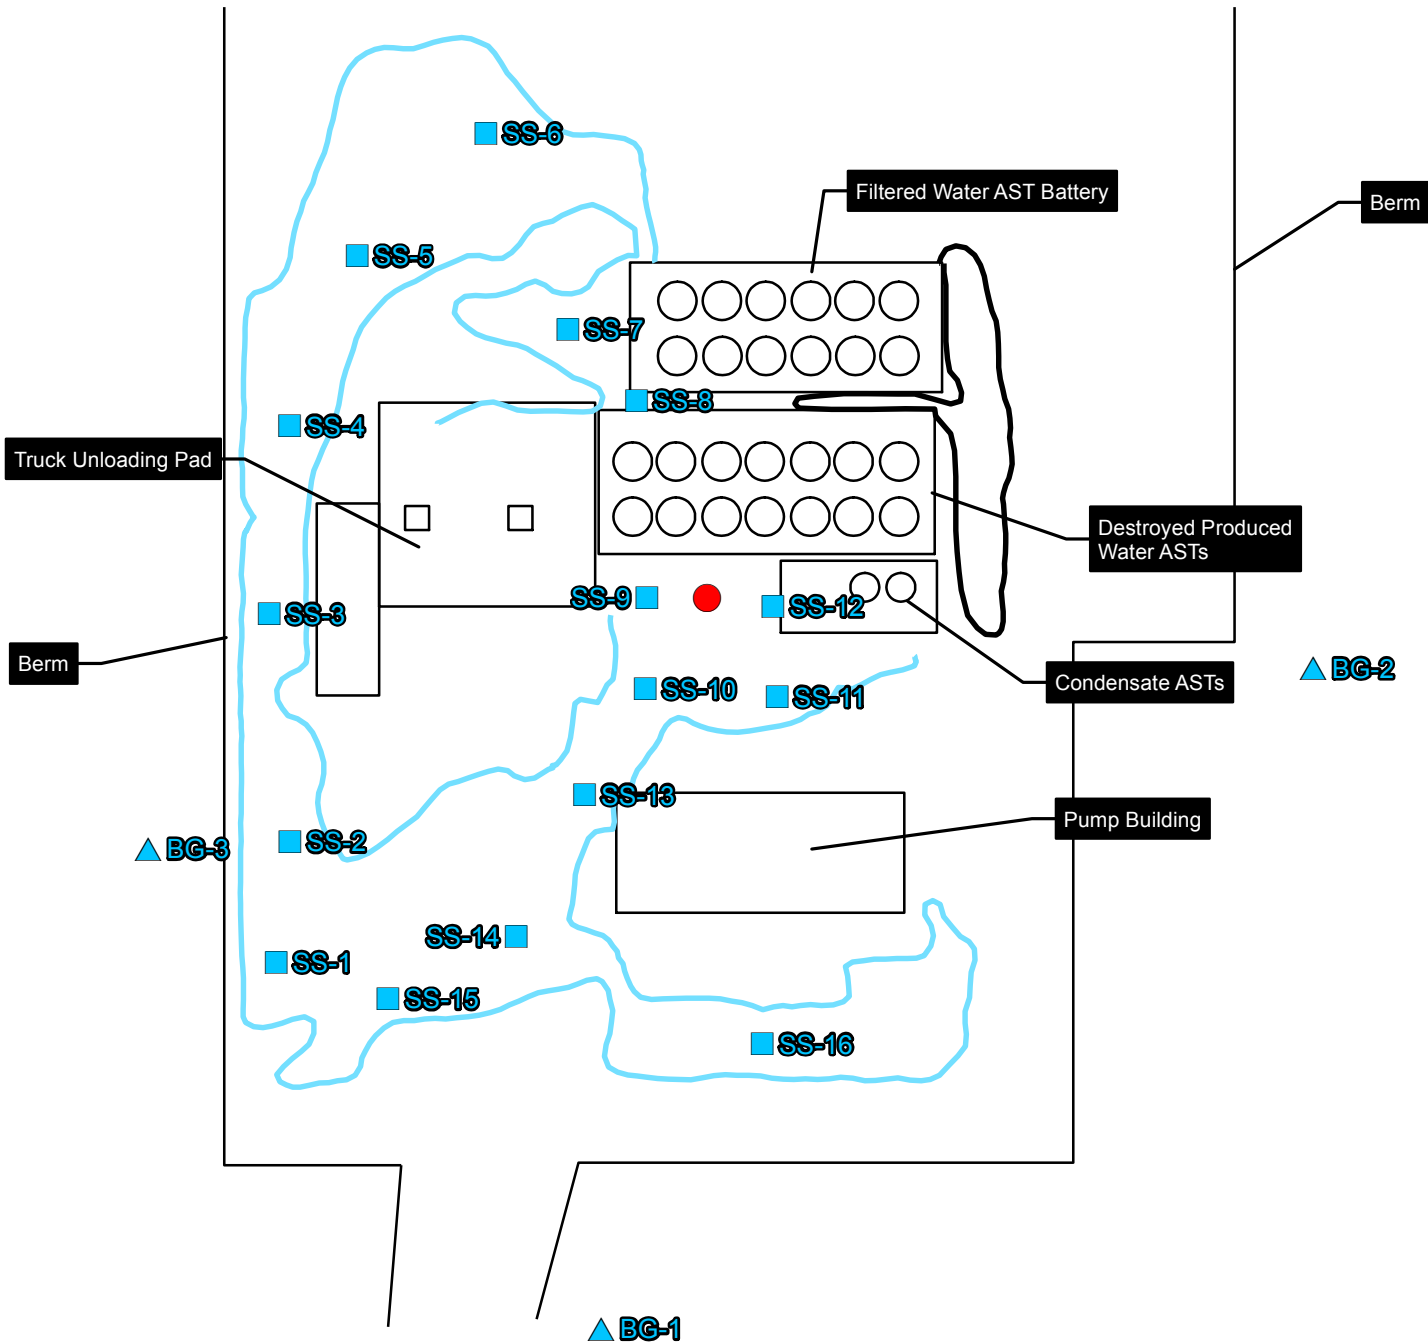

### Legend

- Soil Sample Location
- ▲ Background Soil Sample Location
- Lightning Rod
- Crude Oil Release
- Produced Water Release

**Site Layout**  
**Tallgrass/BNN Energy**  
**Wildhorse 16-13L SWD Release**  
**Emergency Response**  
Weld County, Colorado  
Olsson Project # 016-1077

