


Well Name: DYER USX AB35-13

VERTICAL - ORIGINAL HOLE, 5/17/2016 3:25:42 PM

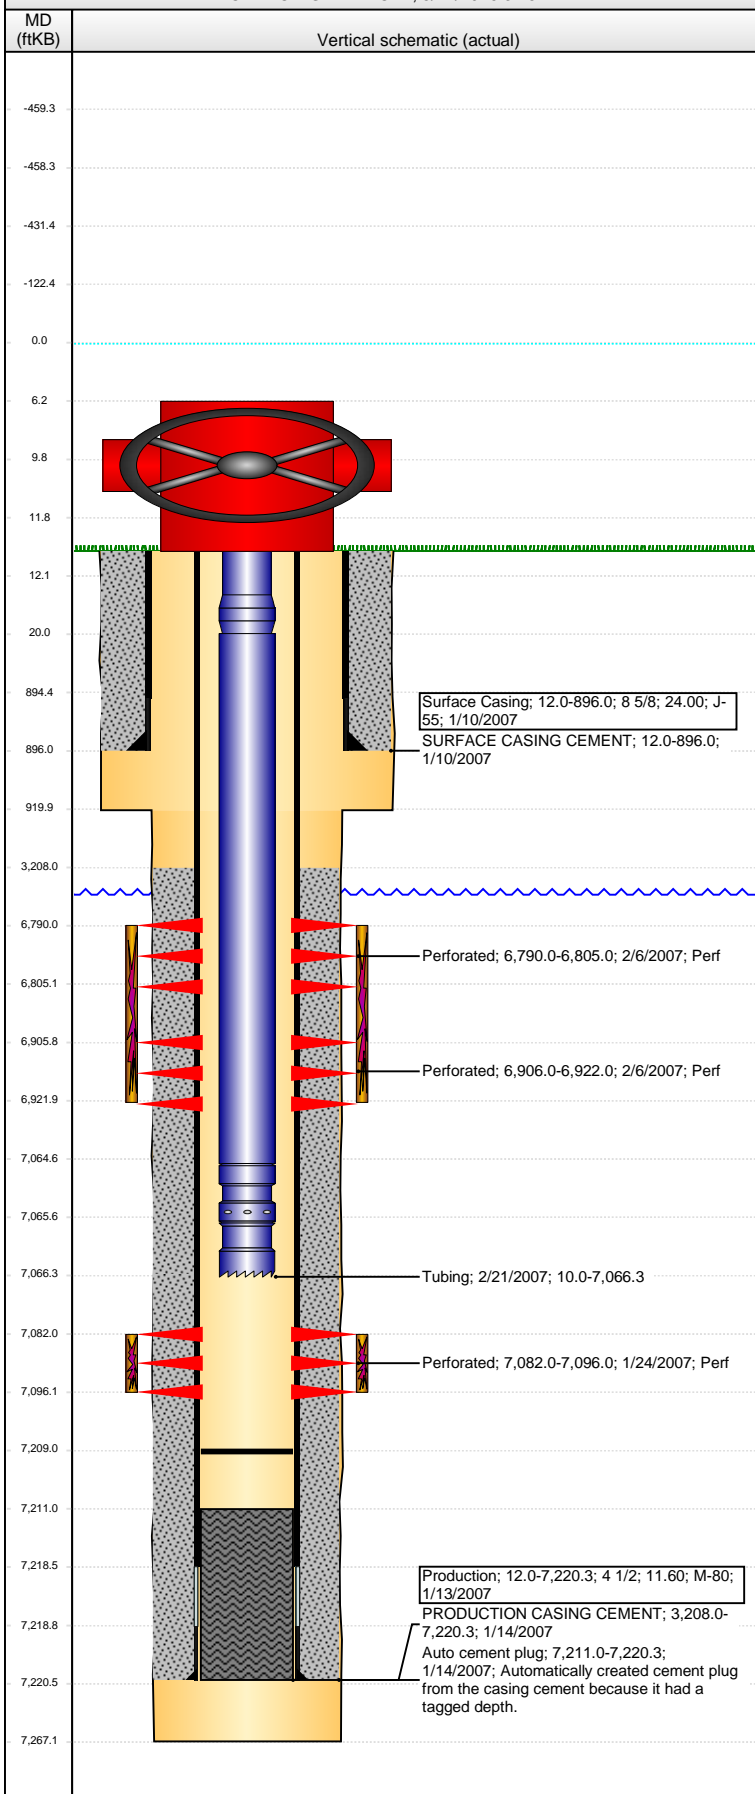

Well Header									
API 05-123-24547		Business Unit DJ BASIN		District 15		Well Config VERTICAL			
Original KB Elevation (ft) 4,836		KB - GL / MSL (ftKB) 12.00		Spud Date 1/9/2007		P & A Date			
Comment PUSH FP TO 7209									
Directions To Well XRDS OF 74/57 E. 25 N.2 W INTO									
Congressional Location									
Quarter 1	Quarter 2	Quarter 3 SW	Quarter 4 SW	Section 35	Township 7 N	Twnshp N...	Range 64	Rng E/W Dir W	
Bottom Hole Location									
North-South Distance (ft)		From N or S Line		East-West Distance (ft)			From E or W Line		
Plug Back Total Depths									
Date	Depth (ftKB)	Method			Com				
1/13/2007	7,219.4	CASING TALLY			FLOAT COLLAR ON CASING TALLY				
1/22/2007	7,211.0	CASED HOLE LOG			DEPTH LOGGER ON CBL				
2/20/2007	7,209.0	TAG			PUSHED CIPF TO +/- 7209				
Wellbore Sections									
Section Des			Size (in)		Act Top, MD (ftKB)		Act Btm, MD (ftKB)		
SURFACE			12 1/4		12.0		920.0		
PRODUCTION			7 7/8		920.0		7,267.0		
Zone Statuses									
Zone Name	Status Date	Status	Fluid Type		Job	Prod Method			
CODELL	2/9/2007	PR			DRILLING/CO...				
NIOBRARA	2/9/2007	PR			DRILLING/CO...				
Casing Strings									
Surface Casing, 896.0ftKB									
Casing Description		Run Date	OD (in)	Wt/Len (l...	Grade	Top, MD (ft...	MD (ftKB)		
Surface Casing		1/10/2007	8 5/8	24.00	J-55	12.0	896.0		
Production, 7,220.4ftKB									
Casing Description		Run Date	OD (in)	Wt/Len (l...	Grade	Top, MD (ft...	MD (ftKB)		
Production		1/13/2007	4 1/2	11.60	M-80	12.0	7,220.4		
Cement									
Description					Top Depth (ftKB)		Bottom Depth (ftKB)		
SURFACE CASING CEMENT					12.0		896.0		
Description					Top Depth (ftKB)		Bottom Depth (ftKB)		
PRODUCTION CASING CEMENT					3,208.0		7,220.4		
Tubing Strings									
Tubing Description		Run Date	String...	ID (in)	Wt (lb/ft)	Grade	Len (ft)	Set De...	
Tubing		2/21/2007	2 3/8	1.995	4.70	J-55	7,056.34		
Tubing Components									
Item Des		OD (in)	Wt (lb/ft)	Grade	Jts	Len (ft)	Btm (ftKB)	Btm (TVD) (ftKB)	
Pup Joint		2 3/8	4.70	J-55	1	10.00	20.0		
EUE 8rd Tubing		2 3/8	4.70	J-55	215	7,044.69	7,064.7		
Seal Nipple		2 3/8				1.00	7,065.7		
Notched collar		2 3/8				0.65	7,066.3		
Perforation Data									
Zone		Bnch/St g	Entered Shot Total	Top (ftKB)		Btm (ftKB)		Date	
NIOBRARA, ORIGINAL HOLE		A	60	6,790.00		6,805.00		2/6/2007	
NIOBRARA, ORIGINAL HOLE		B	64	6,906.00		6,922.00		2/6/2007	
CODELL, ORIGINAL HOLE			56	7,082.00		7,096.00		1/24/2007	
Stimulations & Treatments									
Date	Zone			Primary Job Type					
2/6/2007	NIOBRARA, ORIGINAL HOLE			DRILLING/COMPLETION - ORIGINAL					
Technical Result			Tech Result Details			Tech Result Note			
Comment									
Date	Zone			Primary Job Type					
2/6/2007	CODELL, ORIGINAL HOLE			DRILLING/COMPLETION - ORIGINAL					
Technical Result			Tech Result Details			Tech Result Note			
Comment									

Well Name: DYER USX AB35-13

VERTICAL - ORIGINAL HOLE, 5/17/2016 3:25:44 PM

Other In Hole

Run Date	Des	OD (in)	Top (ftKB)	Btm (ftKB)

Logs

Date	Type	Top, MD (ftKB)	Btm, MD (ftKB)
1/14/2007	COMPENSATED DENSITY	2,790.0	7,247.0
1/14/2007	INDUCTION	896.0	7,267.0
1/22/2007	CBL/CCL/GR	3,051.0	7,209.0

