


Well Name: SHAKLEE 03

VERTICAL - ORIGINAL HOLE, 5/18/2016 3:01:45 PM

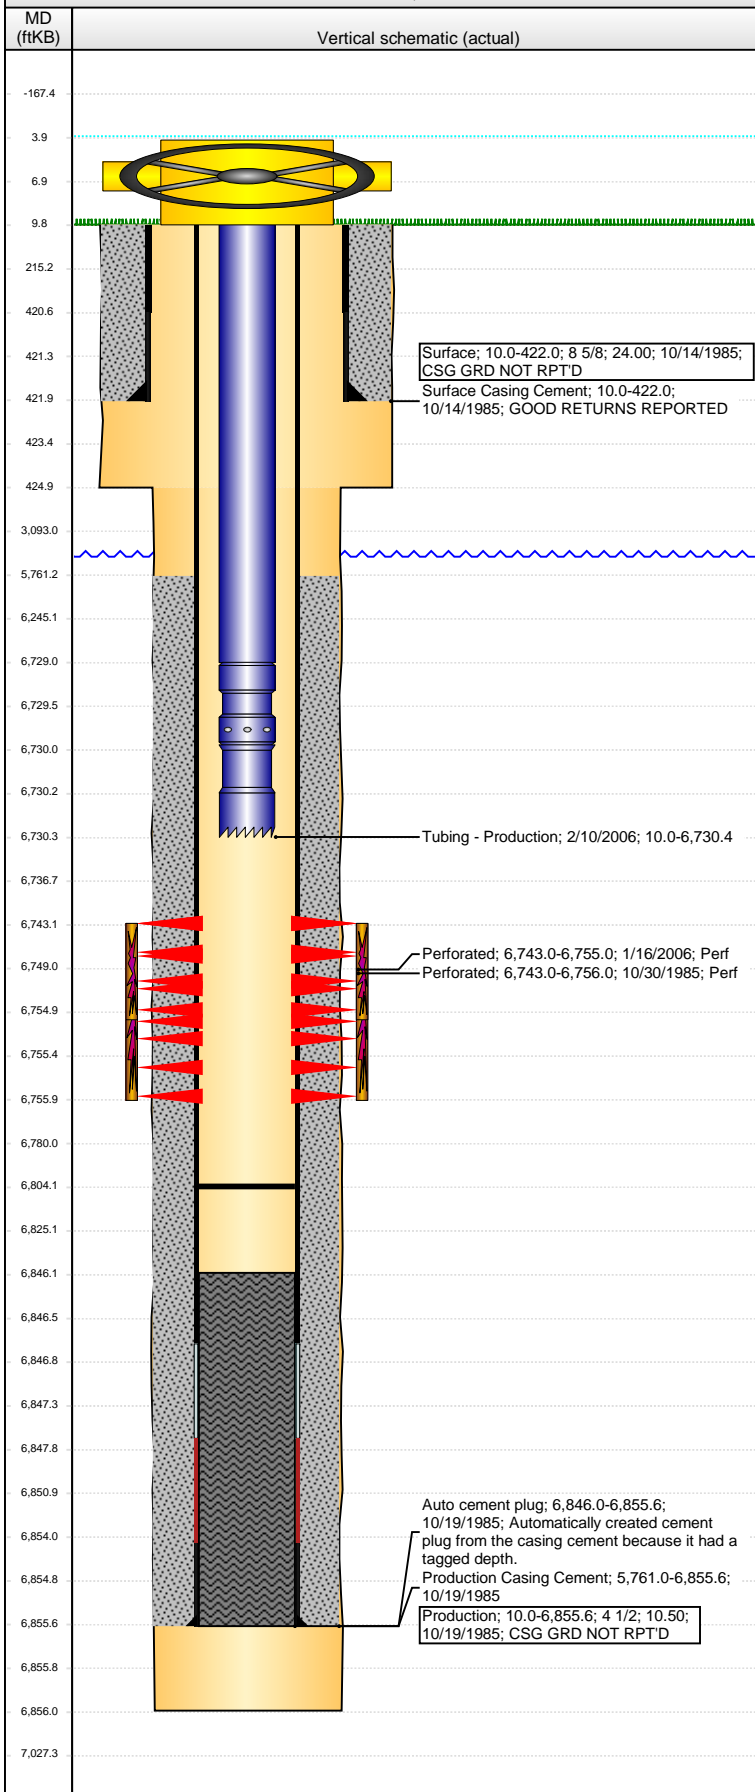

Well Header

API	Business Unit	District	Well Config
05-123-12636	DJ BASIN	15	VERTICAL
Original KB Elevation (ft)	KB - GL / MSL (ftKB)	Spud Date	P & A Date
4,628	10.00	10/14/1985	

Comment
TD DISCREPANCY: DRL RPT = 6853, ST COMP RPT = 6856 (PROD CSG SET DEPTH = 6856).

Directions To Well

Congressional Location

Quarter 1	Quarter 2	Quarter 3	Quarter 4	Section	Township	Twnshp N...	Range	Rng E/W Dir
		NE	SW	2	4	N	64	W

Bottom Hole Location

North-South Distance (ft)	From N or S Line	East-West Distance (ft)	From E or W Line
---------------------------	------------------	-------------------------	------------------

Plug Back Total Depths

Date	Depth (ftKB)	Method	Com
10/19/1985	6,846.0	CASING TALLY	TOP OF GUIDE SHOE W/DIFFERENTIAL COLLAR
10/22/1985	6,780.0	CASED HOLE LOG	DEPTH LOGGER ON CBL
4/17/1989	6,816.0	TAG	CLEAN OUT
2/10/2006	6,804.0	TAG	CLEAN OUT

Wellbore Sections

Section Des	Size (in)	Act Top, MD (ftKB)	Act Btm, MD (ftKB)
SURFACE	12 1/4	10.0	425.0
PRODUCTION	7 7/8	425.0	6,856.0

Zone Statuses

Zone Name	Status Date	Status	Fluid Type	Job	Prod Method
CODELL	12/17/1985	PR		DRILLING/CO...	
CODELL	2/17/2006	PR		RE-FRAC, 1/12...	

Casing Strings

Surface, 422.0ftKB

Casing Description	Run Date	OD (in)	Wt/Len (l...)	Grade	Top, MD (ft...)	MD (ftKB)
Surface	10/14/1985	8 5/8	24.00		10.0	422.0

Production, 6,855.7ftKB

Casing Description	Run Date	OD (in)	Wt/Len (l...)	Grade	Top, MD (ft...)	MD (ftKB)
Production	10/19/1985	4 1/2	10.50		10.0	6,855.7

Cement

Description	Top Depth (ftKB)	Bottom Depth (ftKB)
Surface Casing Cement	10.0	422.0
Description	Top Depth (ftKB)	Bottom Depth (ftKB)
Production Casing Cement	5,761.0	6,855.7

Tubing Strings

Tubing Description	Run Date	String...	ID (in)	Wt (lb/ft)	Grade	Len (ft)	Set De...
Tubing - Production	2/10/2006	2 3/8	1.995	4.70	J-55	6,720.44	

Tubing Components

Item Des	OD (in)	Wt (lb/ft)	Grade	Jts	Len (ft)	Btm (ftKB)	Btm (TVD) (ftKB)
EUE 8rd Tubing	2 3/8	4.70	J-55	212	6,718.84	6,728.8	
Pump Seating Nipple	2 3/8	1.10			1.10	6,729.9	
Notched collar	2 3/8				0.50	6,730.4	

Perforation Data

Zone	Bnch/St g	Entered Shot Total	Top (ftKB)	Btm (ftKB)	Date
CODELL, ORIGINAL HOLE		14	6,743.00	6,756.00	10/30/1985
CODELL, ORIGINAL HOLE		48	6,743.00	6,755.00	1/16/2006

Stimulations & Treatments

Date	Zone	Primary Job Type
11/4/1985	CODELL, ORIGINAL HOLE	DRILLING/COMPLETION - ORIGINAL
Technical Result		Tech Result Details
Comment		Tech Result Note

Date	Zone	Primary Job Type
2/8/2006	CODELL, ORIGINAL HOLE	RE-FRAC
Technical Result		Tech Result Details
Comment		Tech Result Note

Well Name: SHAKLEE 03

VERTICAL - ORIGINAL HOLE, 5/18/2016 3:01:48 PM

Other In Hole

Run Date	Des	OD (in)	Top (ftKB)	Btm (ftKB)

Logs

Date	Type	Top, MD (ftKB)	Btm, MD (ftKB)
10/19/1985	COMPENSATED DENSITY	1,000.0	6,848.0
10/19/1985	INDUCTION	422.0	6,848.0
10/22/1985	CBL/CCL/GR	5,679.0	6,774.0
8/11/2011	GYRO	10.0	6,700.0

