

Current Completion

KB: 8174'

DF: 0.0'

GR: 8168'

Harry Willis 7-4

API: 05 055 06225

330' FNL & 2170' FEL, NWNE/4
Sec 4, T29S, R69W
Huerfano county Colorado

13 3/8", 48#, @ 206
cmt with 280 sxs. TOC at surface

8 5/8", 24#, H-40 csg @ 1675'
cmt with 200 sxs. TOC at surface

D&C: 7/29/2000

OH 2022' - 2247'


Stim: 3000 gal HCL

IP: 330 MCFD @ 355 FTP

9/15/200: clean out w/ CTU

to 2247', SICP 515#

10/20/2000: SI CP 506 PSIG

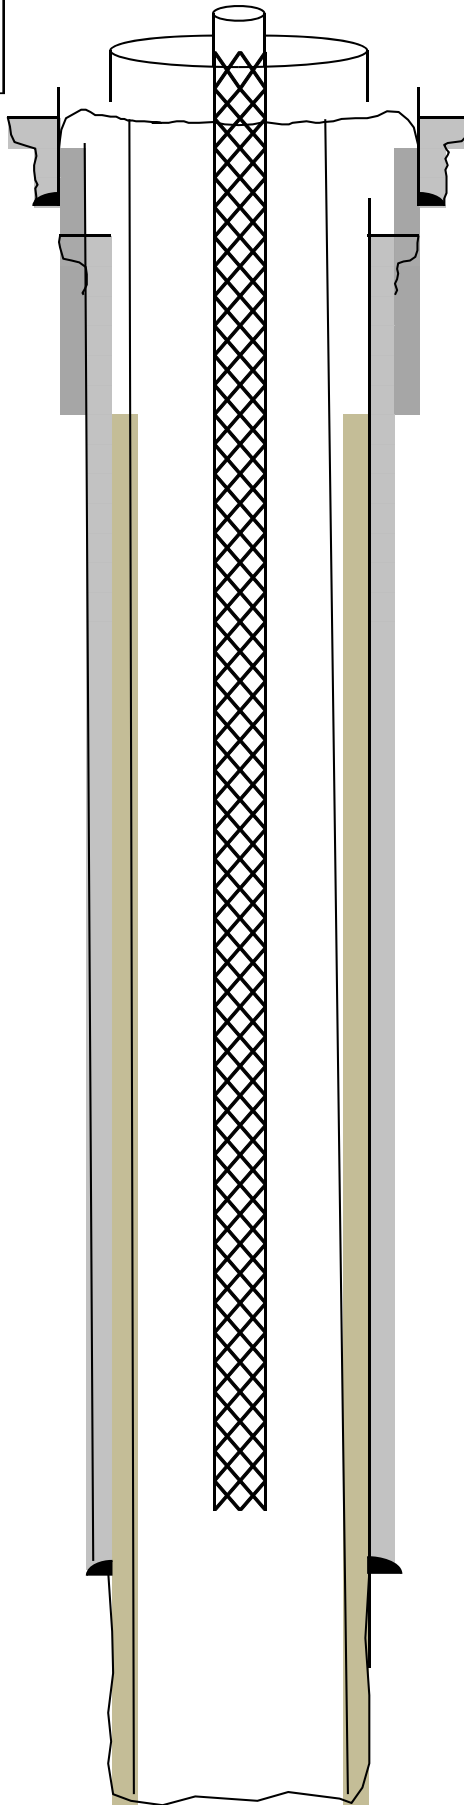

2 7/8". 6.5#, N-80 tbg EOT at 1831
59jts

5 1/2" 14#, J-55 set at 2022'
150 sks

OH 2022' - 2247'

TD = 2247'