



Wexpro Company

1955 Blairtown Road
P. O. Box 458
Rock Springs, WY 82902
Tel 307-352-7555
Fax 307-352-7575

Cathy J. Flansburg
Coordinator, Regulatory Affairs

Facility ID 312918
Document 2526307

May 2, 2002

Bureau of Land Management
Little Snake Field Office
455 Emerson Street
Craig, CO 81625

RE: J. C. Donnell No. 12
NW NE 30-12N-97W
Lease No.: D-039907-b
Unit Agreement No. 892000310A
Moffat County, Colorado


Gentlemen:

In accordance with the Onshore Order No. 3, Site Security Regulations, submitted herewith is a site facilities diagram for the above captioned facility.

This site facility diagram is part of the Powder Wash Unit Plan. The Site Security Plan may be reviewed at the Wexpro Company, Powder Wash Plant office, Monday through Friday, 8:00 a.m. to 4:00 p.m.

If you require further information, please contact me.


Sincerely,

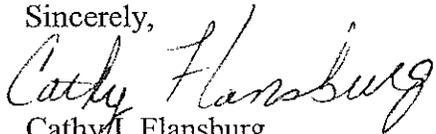
Cathy J. Flansburg
Coordinator, Regulatory Affairs

cjf/enc

cc: L. D. Rasmussen (RSW86)
S. Siamani (QB333)
Regulatory Affairs
D. A. Findlay

J.C. Donnell #12
 NW NE SEC 30-12-97
 D-039907-B
 WEXPRO CO. OPERATOR

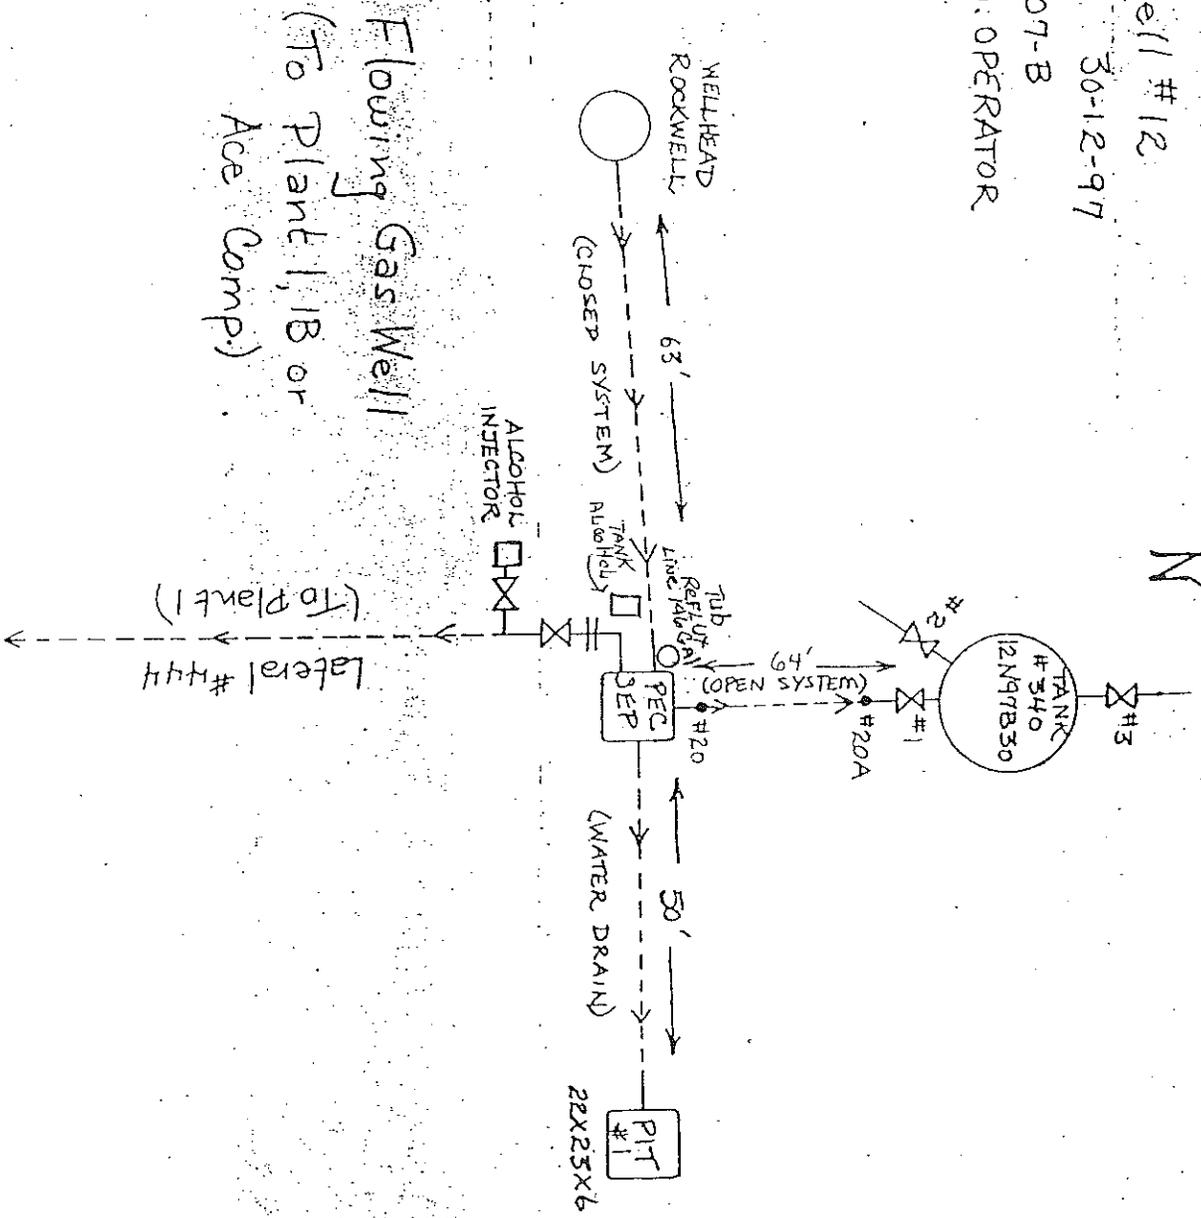

Flowing Gas Well
 (To Plant 1, 1B or
 Ace Comp)

Lateral #444
 (To Plant 1)

LEGEND

Gas Meter

∇ Choke

✕ Valve

● Bull Plug

--- Unknown