


DOWN HOLE MARY

1/17/87

NEW COMPLETION

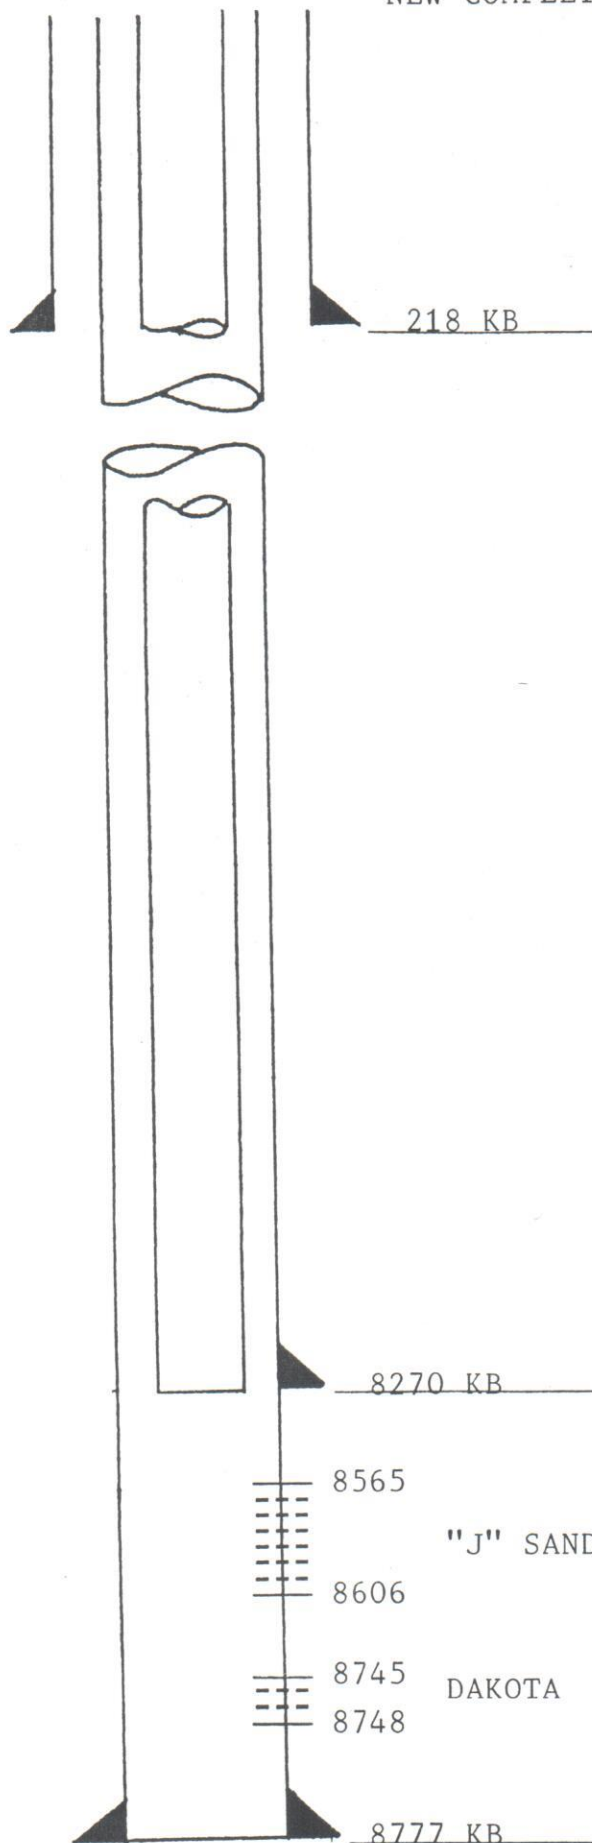

Operator: MARTINEX (SIMLA) CORP.

Well: GINTHER 20-2

Legal: NW NW Section 20 T1S R67W

Adams County, Colorado

Formation: "J" Sand & Dakota

Perforations: "J": 8565, 84, 87, 96, 98, 8600, 02, 04, 06 1JSPF; Dakota: 8745, 48 2JSPF.

Surface Csg: 8 5/8", 24#, K-55 set @ 218 Ft. (6 jts)

Intrm Csg: NA

Prod. Csg: 4.5", 15.1#, N-80 8860.5 ft (250 jts) set @ 8857 KB Cement Basket @ 1204 KB

Tubing: 2 3/8", EUE, 4.7# (USED) set @ 8270.5 ft KB (259 jts)

Packer: NA @

Tbg Anchor: NA @

Seating Nipple: 2 3/8" @ 8241.8 KB

Rod String: FLOWING WELL

Pump: NA @

Gas Anchor: NA @

Mud Anchor: 2 3/8" @ 8270.8 KB

Special Equipment: