



**WELLBORE DIAGRAM**

Current WBD

660' FSL & 1000' FWL

Operator: The California Company  
 Well Name: Francis Steckel 1  
 Lease Number: \_\_\_\_\_  
 Location: SWSW 14-T8N-R66W  
 Field: Pierce  
 County, State: Weld, CO  
 API Number: 05-123-05553  
 Diagram Date: 3/4/2016  
 Lat/Long: 40.655921/-104.751463

KB 5083'

GL 5070'

Placed 25 sx. Regular cement plug in top of surface pipe. 4" pipe embedded in cmt. 3' above GL (9/20/57)


Placed 100sx. Regular cement containing 1% CaCl, balanced plug across shoe of surface pipe 273'-654' (9/20/57)

**Formation Tops**

Deepest Water Well: 48'  
 Base Fox Hills: 1358'  
 Hygiene 3972'  
 Niobrara 7158'  
 Timpas 7447'  
 Carlile 7466'  
 Greenhorn 7682'  
 Graneros 7768'  
 Muddy 7966'  
 Skull Creek 8100'  
 Dakota 8210'  
 Morrison 8360'  
 Entrada 8604'  
 Lykins 8640'  
 Lyons 9278'

Placed 50 sx. Slo-set cement, balanced plug across top of muddy from 7813-7975' (9/20/57)

Placed 50 sx. Slo-set cement, balanced plug across top of Lyons from 9129-9291' (9/20/57)

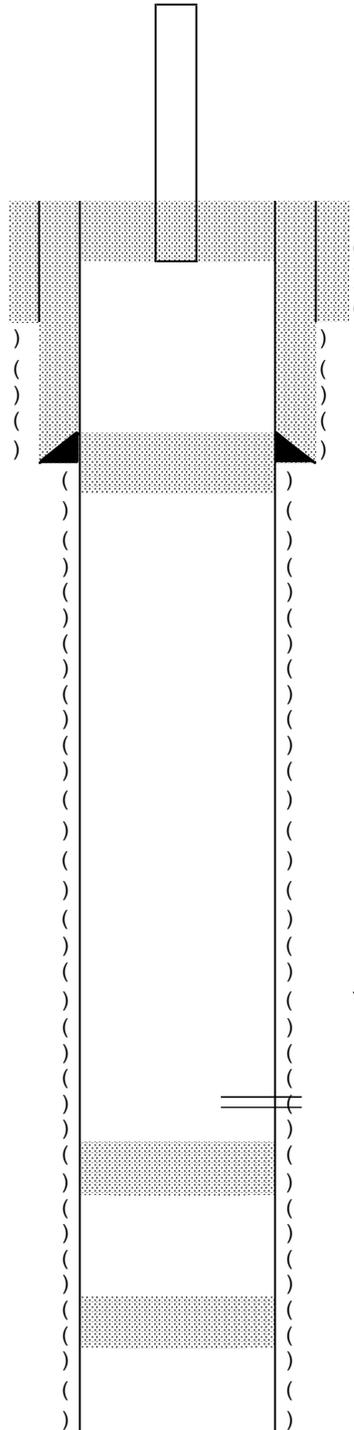

TVD 9360' PBTVD MD

**Well History**

Spud Date: 8/19/1957  
 Date TD Reached: 9/20/1957  
 Original PA Date: 9/20/1957

**Conductor Casing**

18" culvert set @ 31' GL  
 Cmt w/ 5-1/2 yds of Redi-Mix

**Surface Casing**

9-5/8" 40# J-55 set @ 411'  
 cmt'd w/ 375 sx

**Production Casing**

No production casing  
 7-7/8" hole to TD

**Tubing**

no tubing

TOC=

**Perforation/Frac Details**

No perforations