




DRILLING COMPANY, INC.
WICHITA, KANSAS

Current Wellbore Diagram

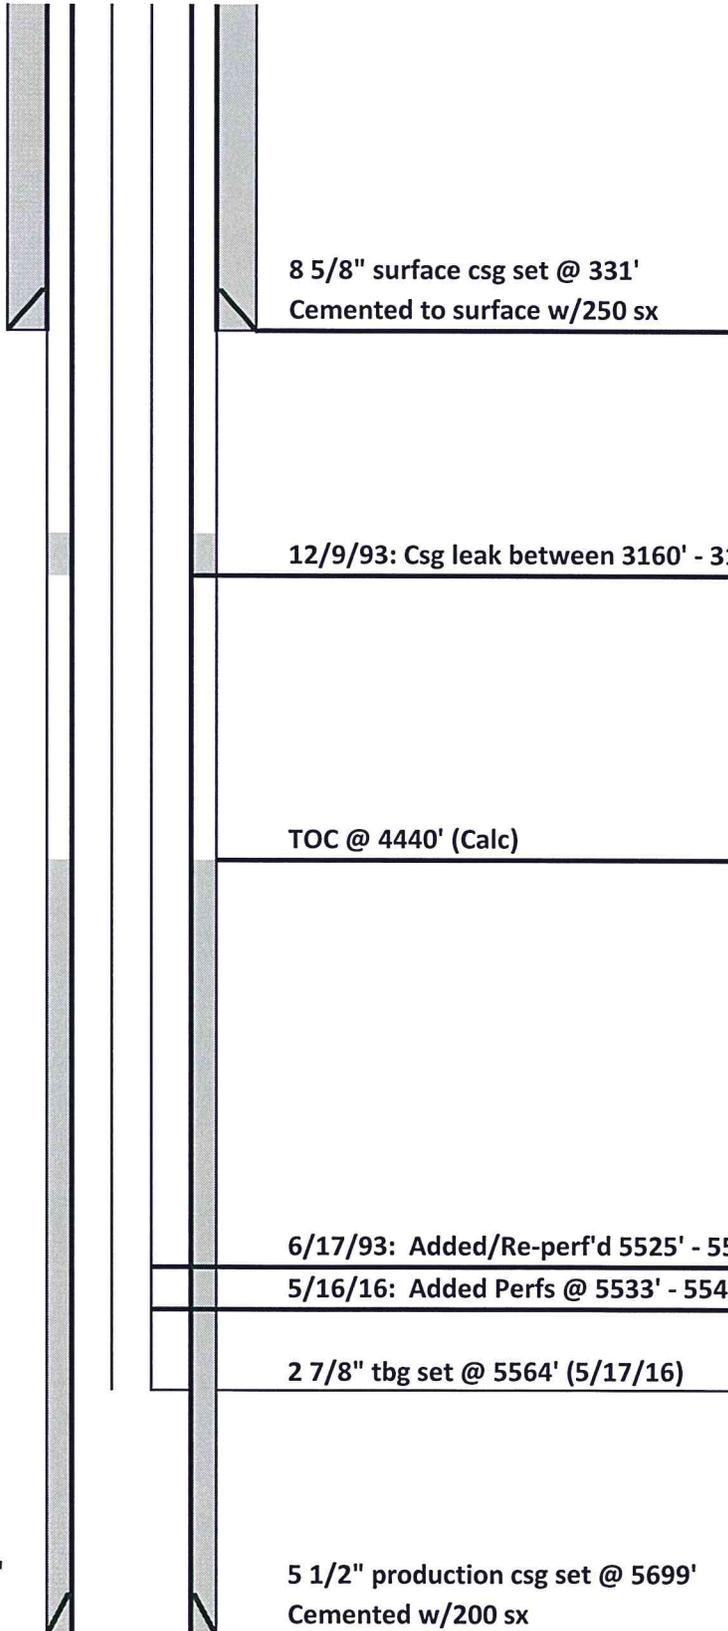

Date: 5/19/2016
Well Name: MUSF #5
F/K/A: Wilkerson "B" #2
Location: 1980' FSL & 1980' FEL
NW/4 SE/4 32-13S-49W
County: Cheyenne
State: Colorado
API: 05-017-06279
GL: 4460'
KB: 4469'
Spud Date: 9/24/1980

PBTD = 5574'
RTD = 5700'