

# Donald E Miller B #1

General Location:


NESW -4-1N-67W

Latitude/Longitude: N40.07826000, W -104.89810000:

County: Weld, State: CO

Spud Date: 7/3/1972

Total Depth: 4820

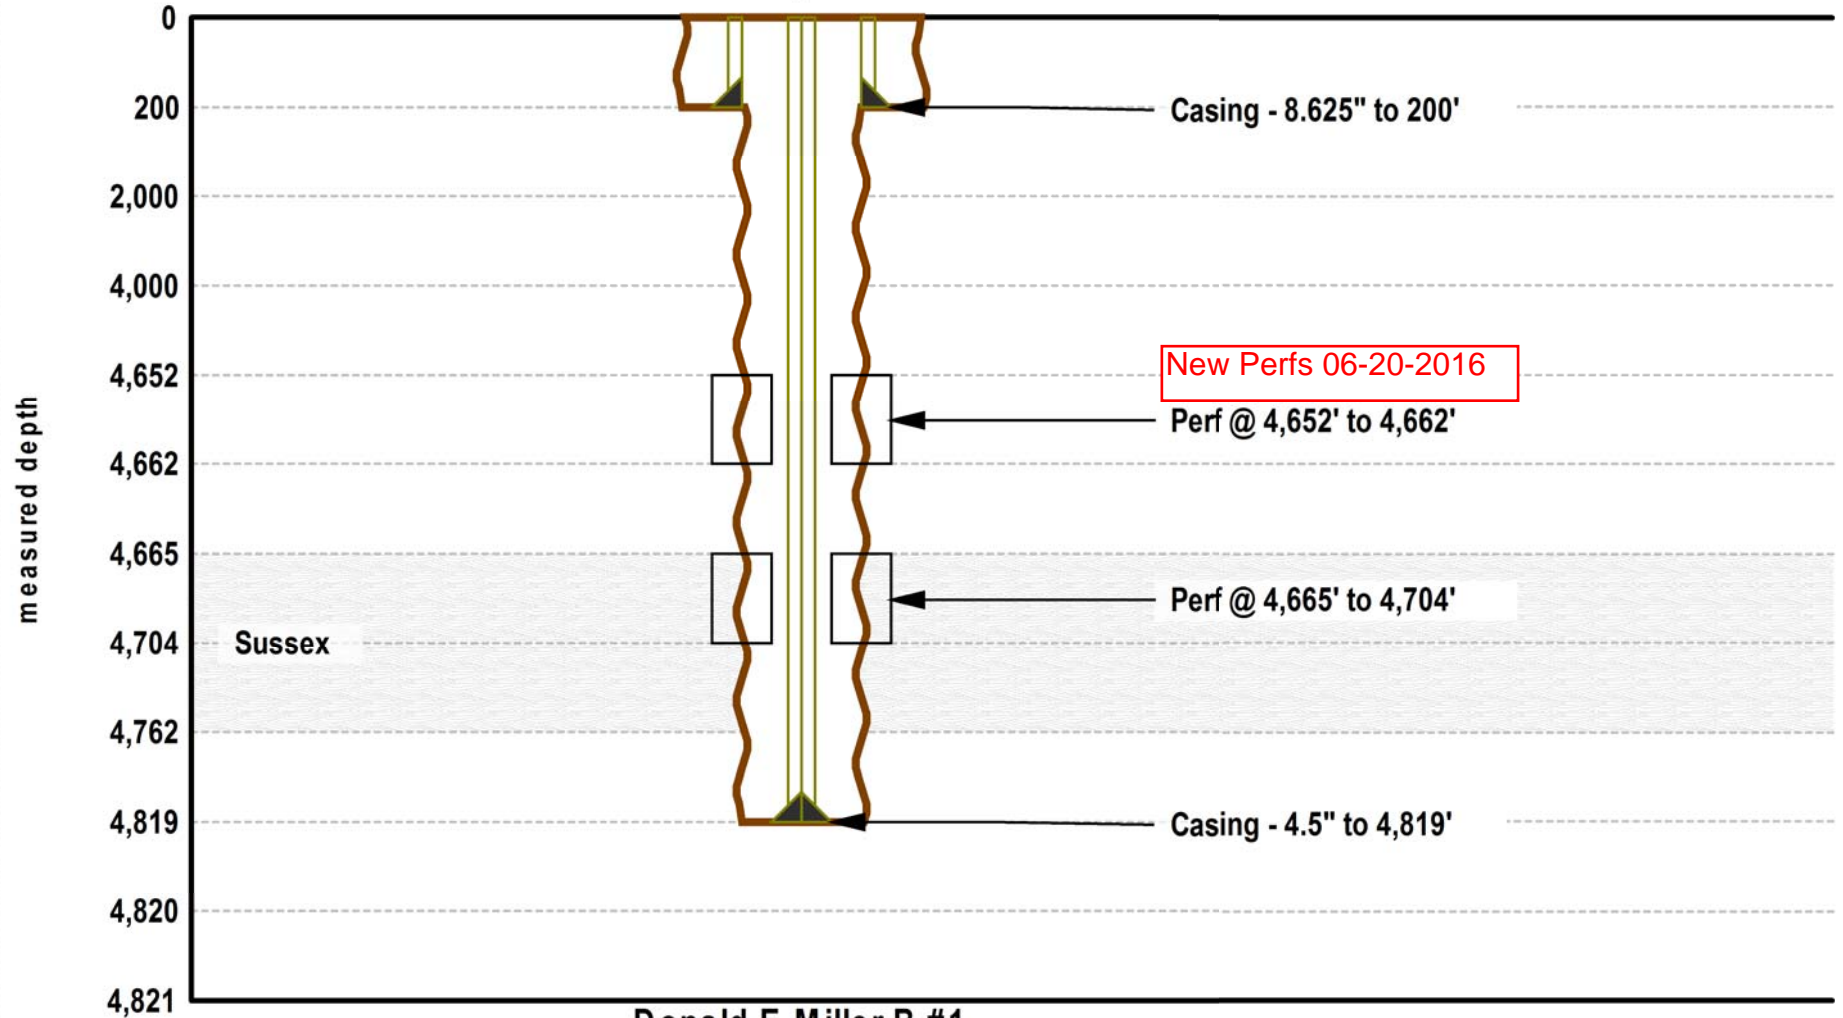

Donald E Miller B #1

Initial Completion: 7/26/1972

Proposed Depth: 0 Plug Back Depth: 4760