


TEP ROCKY MOUNTAIN LLC
RU 513-6
Rulison Field
NWSW S6 T7S R93W

Formation Tops
(Measured Depths)

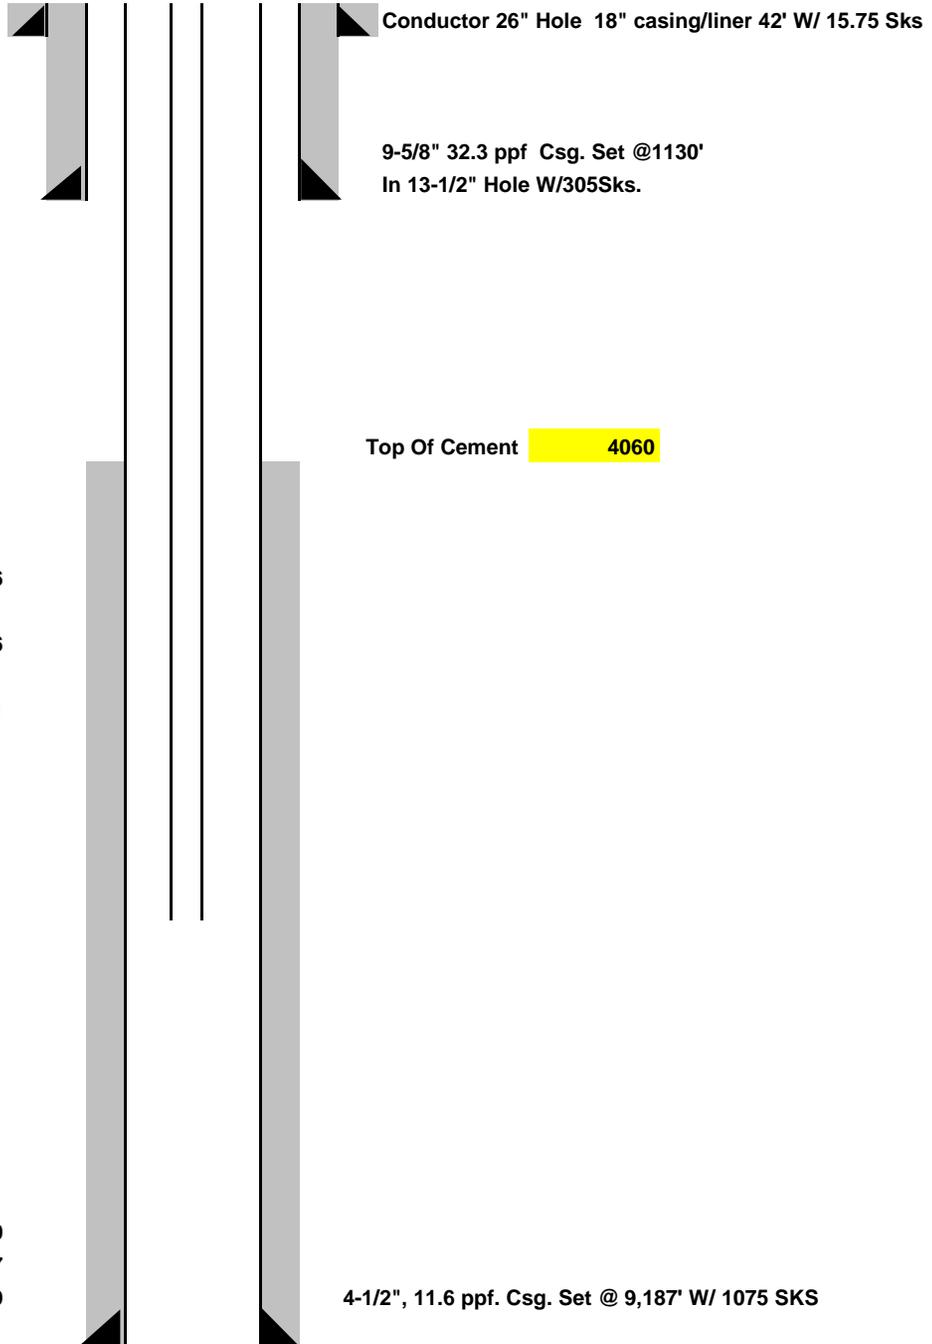

Conductor 26" Hole 18" casing/liner 42' W/ 15.75 Sks

9-5/8" 32.3 ppf Csg. Set @1130'
 In 13-1/2" Hole W/305Sks.

Top Of Cement **4060**

"G" Sand @ 2926

Mesaverde @ 5386

Cameo @ 8151

Tubing not set

PBTD @ 9170

TMD @ 9197

TVD @ 9179

4-1/2", 11.6 ppf. Csg. Set @ 9,187' W/ 1075 SKS