OPERATOR:	Peterson Energy Operating, Inc.	CNTY:	Weld	FTG:	990 FSL and 1600 FWL	IP GAS:	
WELL:	Thomason #1	STATE:	CO	Q-Q:	SESW	IP OIL:	
FIELD:	Wattenberg	ROTARY SPUD:	16-Oct-73	SEC.:	16	IP WTR:	
API #	05-123-07892	COMP:	18-Oct-74	TWS:	2N	CUM GAS:	
LEASE #:	-	STATUS:	PR	RGE:	65W	CUM OIL:	
UIC #:	-	WBD DATE:	26-Jan-16	BY:	RJD	CUM WTR:	
BASIN:	Denver - Julesburg	LAT/LONG:	40.134191, -104.672677			LAST PROD:	

EXISTING WELLBORE DIAGRAM

KBE: 4900.0 '
KB: 14.0 '
GLE: 4886.0 '

TD (ft): 7810 '
PBTD (ft): 7765 '

8 5/8" 24# Csg @ 233 '
w/ 200 sxs

Base Foxhills @ 740 '

DV Tool @ 817 '
Cmtd w 225 sx to Surface

Top Sussex @ 4510 '

Top Niobrara @ 6930 '

CALC TOC @ 7000 '

Top Codell @ 7215 '

Top J Silt @ 7645 '

6/6/2014 EOT @ 7655 '

Top J Sand @ 7660 '

J Sand 7664' - 6772'

J Sand 7692' - 7705'

ORIG PBTD @ 7765 '
4 1/2" 11.6/10.5# Csg @ 7799 '
Cmtd w/ 200 sxs
TD @ 7810 '
7 7/8" Hole

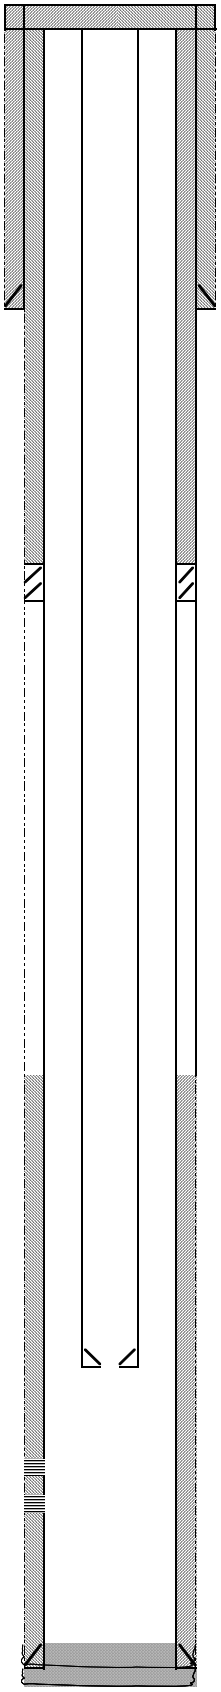

CASING HEAD: Unknown
TUBING HEAD: 2000# Flanged

CASING RECORD

HOLE (in)	SIZE (in)	WT (lb/ft)	GRADE	TOP (ft)	BTM (ft)	JTS
12 1/4	8 5/8	24		0	233	
7 7/8	4 1/2	11.6/10.5		0	7799	

DV Tool @ 817

TUBING RECORD COND: DATE: 6-Jun-14

SIZE (in)	WT (lb/ft)	GRADE	TOP (ft)	TALLY (ft)	JTS	
2 3/8	4.7	JFBNAU	0	7644.26	248	est

ITEM	DESC	SIZE (in)	TALLY (ft)	JTS
K.B.		-	10.00	
HANGER		-		
TBG	Production Tubing	2 3/8	7644.26	248
SN		2 3/8	1.10	
Notch Collar				
EOT @		2 3/8	7655.36	

PERFORATION RECORD

ZONE	TOP (ft)	BTM (ft)	SPF	DATE SHOT	STATUS	STIM
J Sand	7664	7672	5 Holes	Oct-74	PR	Fraced and Acidized
J Sand	7692	7705	2	Oct-74	PR	Fraced and Acidized

WELLWORK HISTORY

500 gal 71/2% MCA, +105,000# 100 Mesh Sand; 302,000# 20/40; 118,000# 10/20 - 6641 bbls emulse-frac.