


WELLBORE DIAGRAM
Edge Energy, LLC
Flaherty 18-13-12NBH
 2174' FSL, 160' FWL
 NWSW Sec 18-T4N-R62W
 Weld County, CO
 05-123-42434-01

Updated
 6/27/2016
 PAG

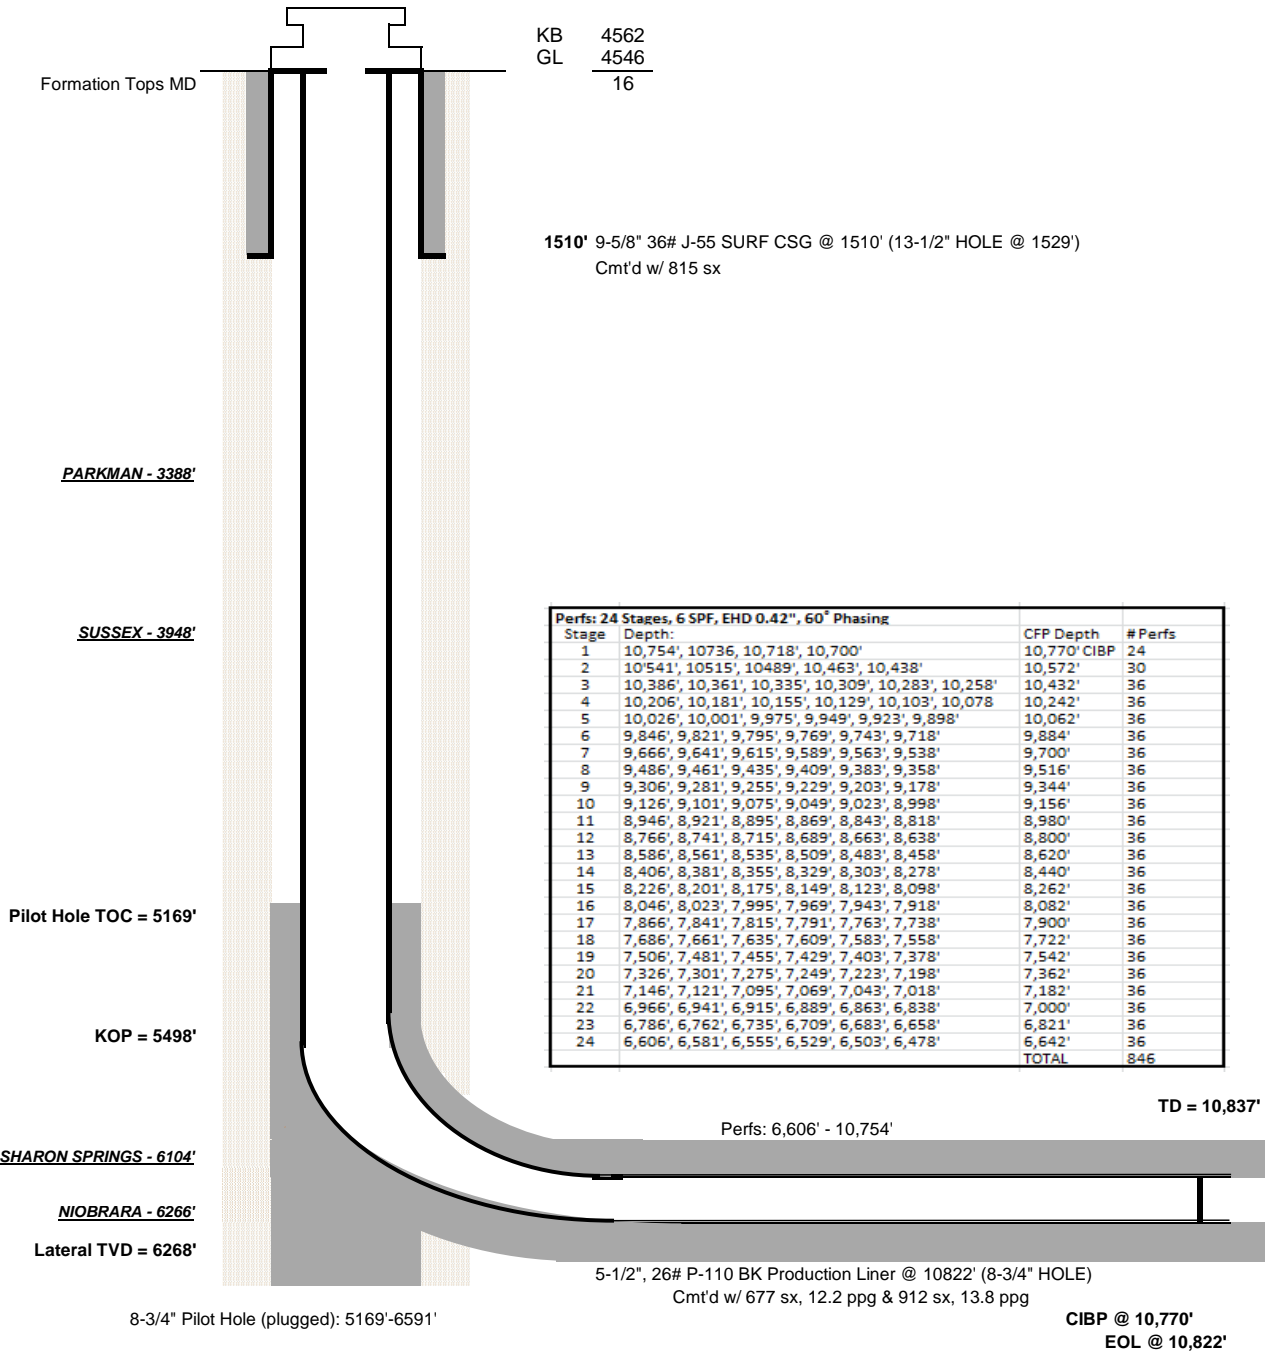

NOT TO SCALE