


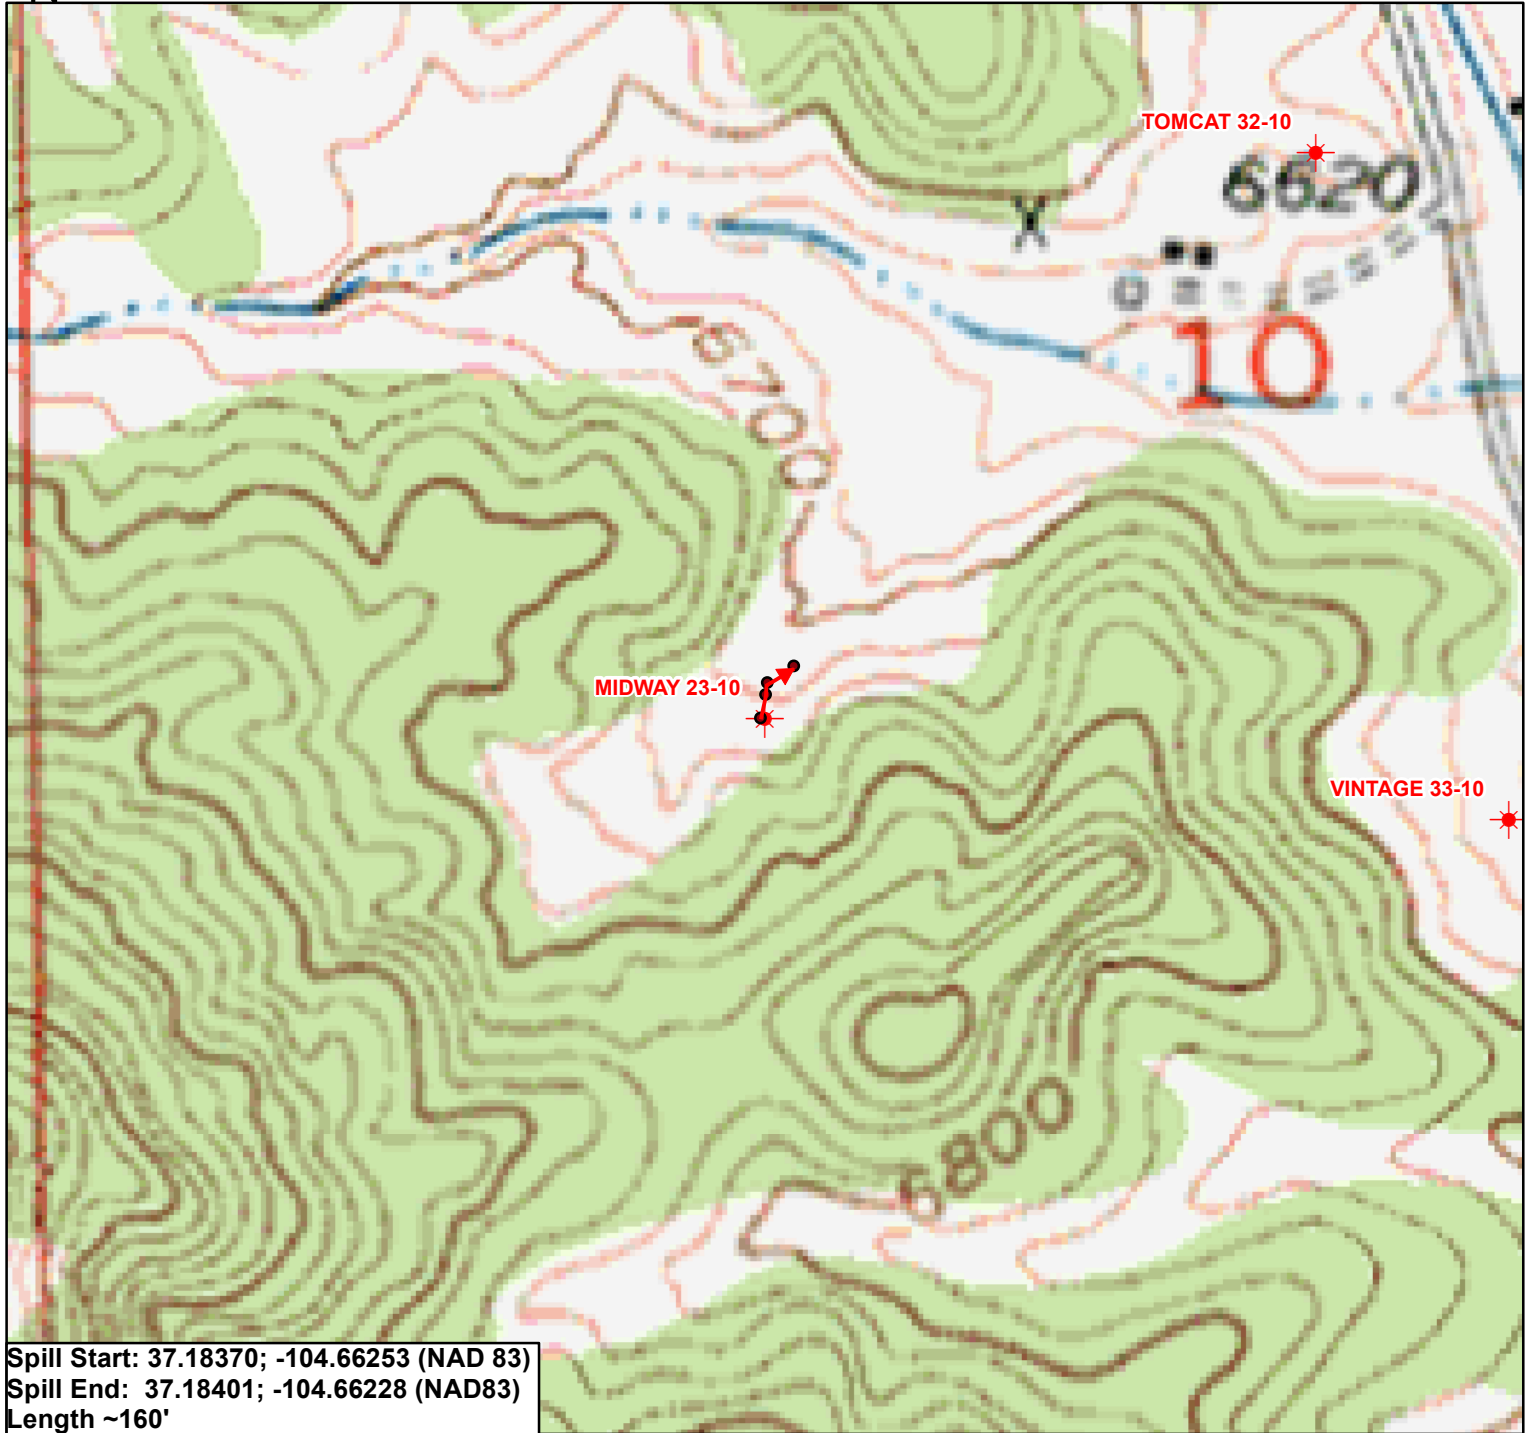

Topographic Spill Map

Midway 23-10 Spill

PIONEER
NATURAL RESOURCES



★ Permitted Well

→ Spill Path

0 250 500 750 1,000 Feet

1:5,000