


**Well Name: DCD FARMS A26-02**

VERTICAL - ORIGINAL HOLE, 2/16/2016 1:18:19 PM

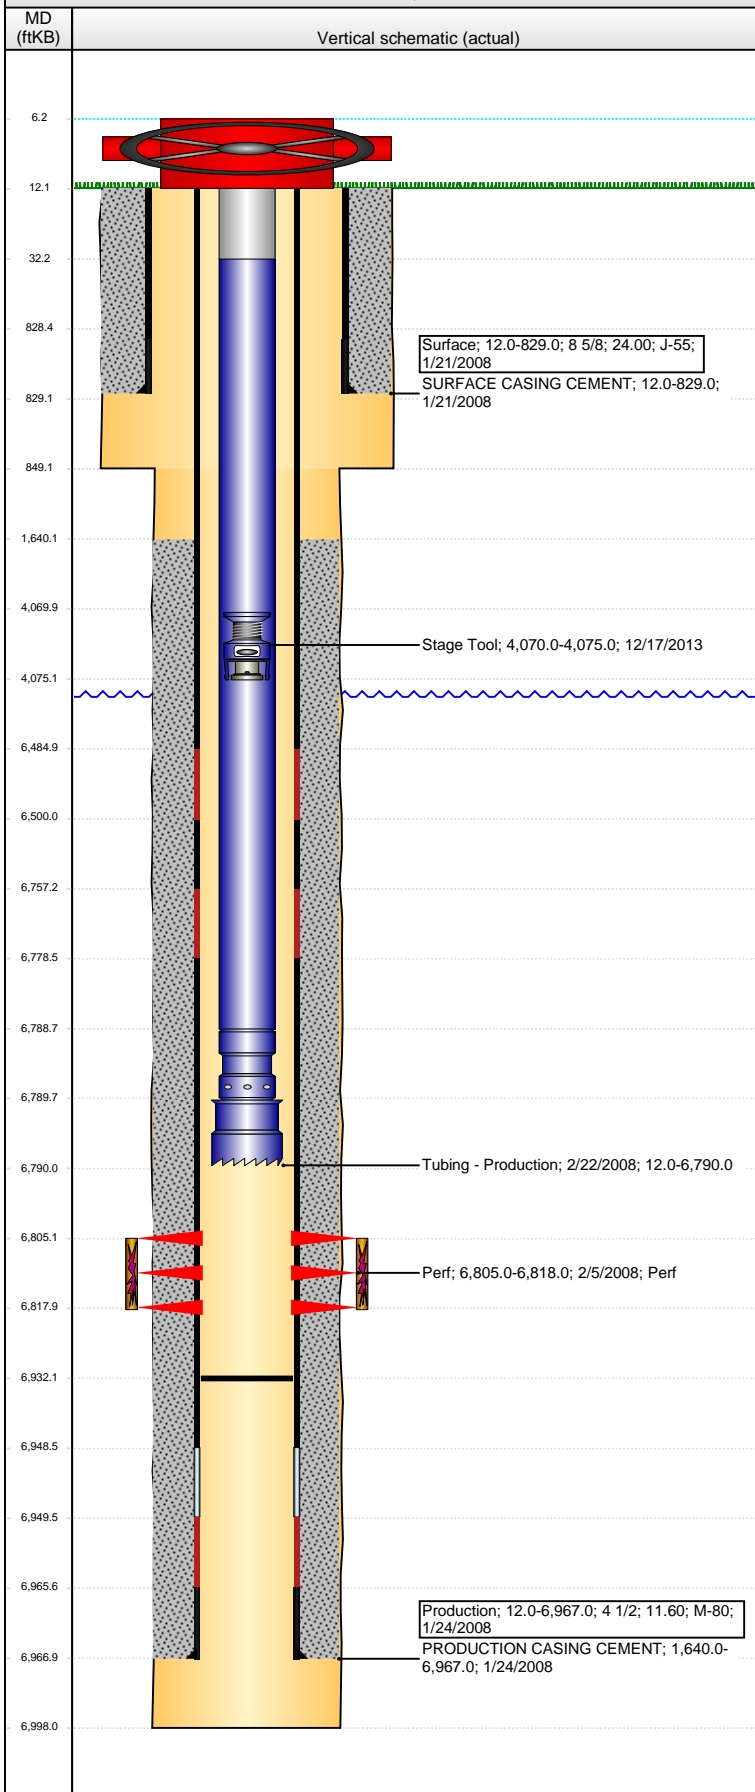

| Well Header  |                               |                               |  |  |                             |                         |                                |                  |  |
|--|-------------------------------|-------------------------------|--|--|-----------------------------|-------------------------|--------------------------------|------------------|--|
| API<br>05-123-26387  |                               | Business Unit<br>DJ BASIN     |  | District<br>15                                     |                             | Well Config<br>VERTICAL |                                |                  |  |
| Original KB Elevation (ft)<br>4,645.00                                       |                               | KB - GL / MSL (ftKB)<br>12.00 |  | Spud Date<br>1/20/2008                             |                             | P & A Date              |                                |                  |  |
| Comment  |                               |                               |  |  |                             |                         |                                |                  |  |
| Directions To Well<br>WCR 59 & 66, South 2/10, West 3/10, North 1/10         |                               |                               |  |  |                             |                         |                                |                  |  |
| Congressional Location   |                               |                               |  |  |                             |                         |                                |                  |  |
| Quarter 1  | Quarter 2                     | Quarter 3<br>NW               | Quarter 4<br>NE                          | Section<br>26                                      | Township<br>6 N             | Twnshp N...             | Range<br>64                    | Rng E/W Dir<br>W |  |
| Bottom Hole Location   |                               |                               |  |  |                             |                         |                                |                  |  |
| North-South Distance (ft)<br>760.0   |                               | From N or S Line<br>FNL       |  | East-West Distance (ft)<br>1,990.0                 |                             | From E or W Line<br>FEL |                                |                  |  |
| Plug Back Total Depths   |                               |                               |  |  |                             |                         |                                |                  |  |
| Date   | Depth (ftKB)                  | Method                        |  |  | Com                         |                         |                                |                  |  |
| 1/24/2008  | 6,949.0                       | CASING TALLY                  |  |  |                             |                         |                                |                  |  |
| 2/4/2008   | 6,932.0                       | CASED HOLE LOG                |  |  |                             |                         |                                |                  |  |
| Wellbore Sections  |                               |                               |  |  |                             |                         |                                |                  |  |
| Section Des  |                               |                               | Size (in)                                |  | Act Top, MD (ftKB)          |                         | Act Btm, MD (ftKB)             |                  |  |
| SURFACE  |                               |                               | 12 1/4                                   |  | 12.0                        |                         | 849.0                          |                  |  |
| PRODUCTION   |                               |                               | 7 7/8                                    |  | 849.0                       |                         | 6,998.0                        |                  |  |
| Zone Statuses  |                               |                               |  |  |                             |                         |                                |                  |  |
| Zone Name  | Status Date                   | Status                        | Fluid Type                               | Job  | Prod Method                 |                         |                                |                  |  |
| CODELL   | 3/7/2008                      | PR                            | Gas                                      | DRILLING/CO...                                     | Flowing                     |                         |                                |                  |  |
| CODELL   | 2/1/2010                      | PR                            | Water                                    |  |                             |                         |                                |                  |  |
| CODELL   | 9/9/2015                      | PR                            |  |  |                             |                         |                                |                  |  |
| Casing Strings   |                               |                               |  |  |                             |                         |                                |                  |  |
| Surface, 829.0ftKB   |                               |                               |  |  |                             |                         |                                |                  |  |
| Casing Description<br>Surface  |                               | Run Date<br>1/21/2008         | OD (in)<br>8 5/8                         | Wt/Len (l...<br>24.00                              | Grade<br>J-55               | Top, MD (ft...<br>12.0  | MD (ftKB)<br>829.0             |                  |  |
| Production, 6,967.0ftKB  |                               |                               |  |  |                             |                         |                                |                  |  |
| Casing Description<br>Production   |                               | Run Date<br>1/24/2008         | OD (in)<br>4 1/2                         | Wt/Len (l...<br>11.60                              | Grade<br>M-80               | Top, MD (ft...<br>12.0  | MD (ftKB)<br>6,967.0           |                  |  |
| Cement   |                               |                               |  |  |                             |                         |                                |                  |  |
| Description<br>SURFACE CASING CEMENT   |                               |                               |  |  | Top Depth (ftKB)<br>12.0    |                         | Bottom Depth (ftKB)<br>829.0   |                  |  |
| Description<br>PRODUCTION CASING CEMENT                                      |                               |                               |  |  | Top Depth (ftKB)<br>1,640.0 |                         | Bottom Depth (ftKB)<br>6,967.0 |                  |  |
| Tubing Strings   |                               |                               |  |  |                             |                         |                                |                  |  |
| Tubing Description<br>Tubing - Production                                    |                               | Run Date<br>2/22/2008         | String...<br>2 3/8                       | ID (in)<br>1.995                                   | Wt (lb/ft)<br>4.70          | Grade<br>J-55           | Len (ft)<br>6,777.96           | Set De...        |  |
| Tubing Components  |                               |                               |  |  |                             |                         |                                |                  |  |
| Item Des   | OD (in)                       | Wt (lb/ft)                    | Grade                                    | Jts  | Len (ft)                    | Btm (ftKB)              | Btm (TVD)<br>(ftKB)            |                  |  |
| Tubing Pup Joint   | 2 3/8                         | 4.70                          | J-55                                     | 2  | 20.00                       | 32.0                    |                                |                  |  |
| Tubing   | 2 3/8                         | 4.70                          | J-55                                     | 217  | 6,756.56                    | 6,788.6                 |                                |                  |  |
| Pump Seating Nipple  | 2 3/8                         |                               |  | 1  | 1.10                        | 6,789.7                 |                                |                  |  |
| Notched collar   | 3 1/16                        |                               |  | 1  | 0.30                        | 6,790.0                 |                                |                  |  |
| Perforation Data   |                               |                               |  |  |                             |                         |                                |                  |  |
| Zone   |                               | Bnch/St<br>g                  | Entered<br>Shot Total                    | Top (ftKB)   |                             | Btm (ftKB)              |                                | Date             |  |
| CODELL, ORIGINAL HOLE  |                               |                               | 52                                       | 6,805.00   |                             | 6,818.00                |                                | 2/5/2008         |  |
| Stimulations & Treatments  |                               |                               |  |  |                             |                         |                                |                  |  |
| Date<br>3/3/2008   | Zone<br>CODELL, ORIGINAL HOLE |                               |  | Primary Job Type<br>DRILLING/COMPLETION - ORIGINAL |                             |                         |                                |                  |  |
| Technical Result<br>Success  |                               |                               | Tech Result Details<br>According to Plan |  |                             | Tech Result Note        |                                |                  |  |
| Comment<br>FRAC THE CODELL DOWN A 2-3/8" DEAD STRING - NO PROBLEMS TO REPORT |                               |                               |  |  |                             |                         |                                |                  |  |
| Other In Hole  |                               |                               |  |  |                             |                         |                                |                  |  |
| Run Date   | Des                           |                               |  |  | OD (in)                     | Top (ftKB)              | Btm (ftKB)                     |                  |  |
| 12/17/2013   | Stage Tool                    |                               |  |  | 2                           | 4,070.0                 | 4,075.0                        |                  |  |

**Well Name: DCD FARMS A26-02**

VERTICAL - ORIGINAL HOLE, 2/16/2016 1:18:21 PM

## Logs

