


**LEGEND:**

- └─┘ = 90° SYMBOL
- = AS-DRILLED WELLHEAD.
- ▲ = SECTION CORNERS LOCATED. (NAD 83)

T7N, R80W, 6th P.M.

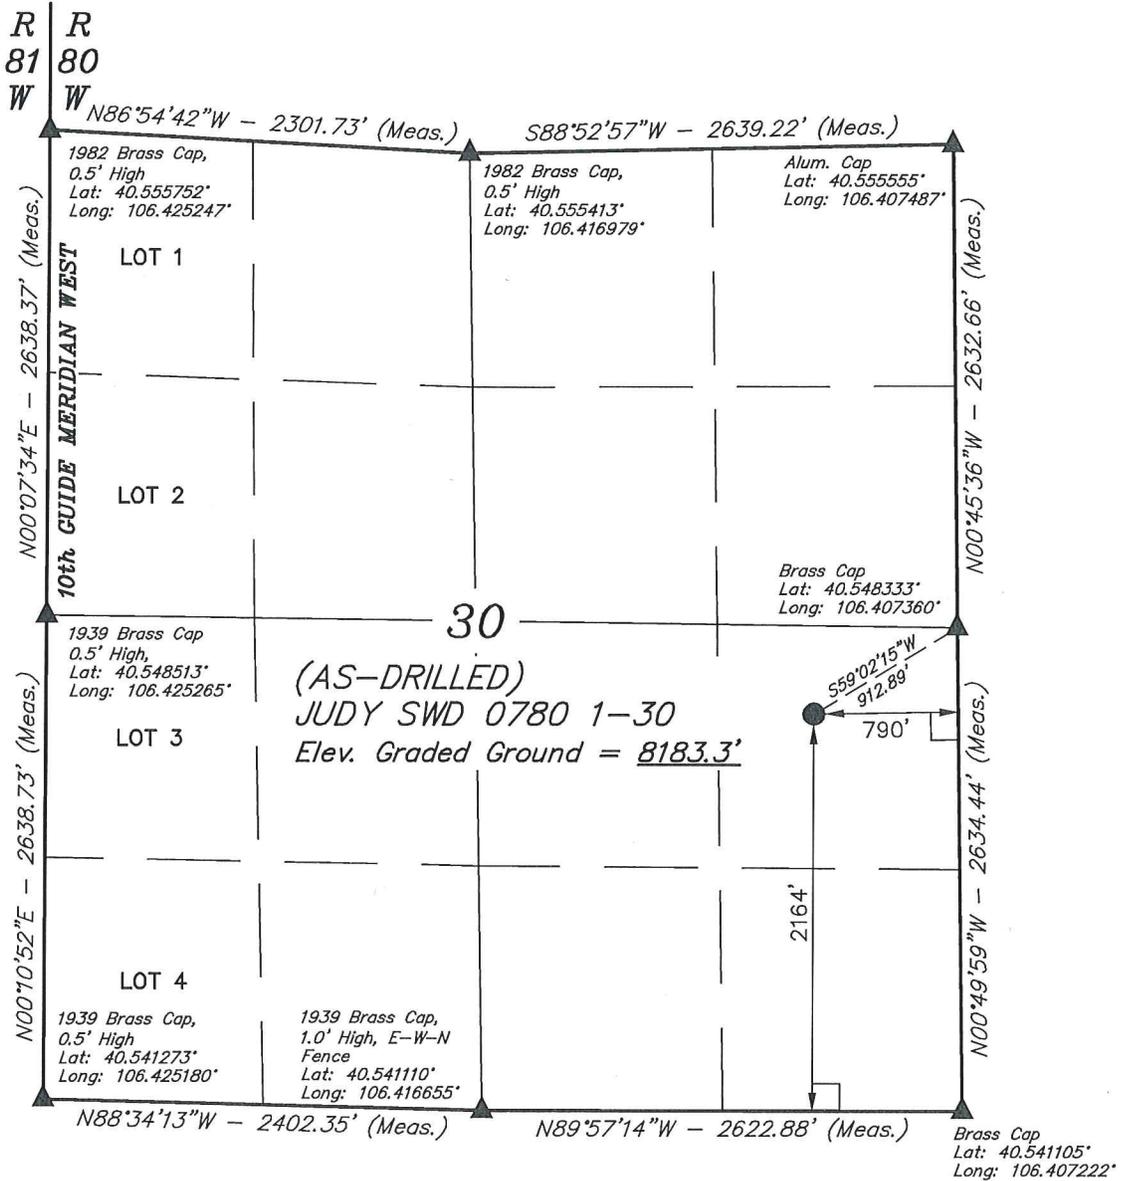

<b>NAD 83 (AS-DRILLED SURFACE LOCATION)</b>
LATITUDE = 40°32'49.36" (40.547044)
LONGITUDE = 106°24'36.63" (106.410175)
<b>NAD 27 (AS-DRILLED SURFACE LOCATION)</b>
LATITUDE = 40°32'49.43" (40.547064)
LONGITUDE = 106°24'34.52" (106.409589)
<b>STATE PLANE NAD 83 (CO. NORTH)</b>
N: 1443427.00 E: 2747060.88
<b>STATE PLANE NAD 27 (CO. NORTH)</b>
N: 443424.83 E: 1747217.27

PDOP = 1.6

CERTIFICATE  
 THIS IS TO CERTIFY THAT THE ABOVE PLAT WAS PREPARED FROM FIELD NOTES OF ACTUAL SURVEYS MADE BY ME OR UNDER MY SUPERVISION, AND THAT THE SAME ARE TRUE AND CORRECT TO THE BEST OF MY KNOWLEDGE AND BELIEF.



REV: 1 06-23-16 C.D.L. (NAME CHANGE)

**BASIS OF BEARINGS**  
 BASIS OF BEARINGS IS A G.P.S. OBSERVATION

**BASIS OF ELEVATION**  
 SPOT ELEVATION LOCATED AT THE SOUTHEAST CORNER OF SECTION 29, T7N, R80W, 6th P.M. TAKEN FROM THE COALMONT QUADRANGLE, COLORADO, JACKSON COUNTY, 7.5 MINUTE QUAD. (TOPOGRAPHIC MAP) PUBLISHED BY THE UNITED STATES DEPARTMENT OF THE INTERIOR, GEOLOGICAL SURVEY. SAID ELEVATION IS MARKED AS BEING 8156 FBET.



**UELS, LLC**  
 Corporate Office \* 85 South 200 East  
 Vernal, UT 84078 \* (435) 789-1017



**SandRidge Exploration & Production, LLC**

(AS-DRILLED) JUDY SWD 0780 1-30  
 NE 1/4 SE 1/4, SECTION 30, T7N, R80W, 6th P.M.  
 JACKSON COUNTY, COLORADO

<b>SURVEYED BY</b>	DARREN SHANKS, G.W.	06-10-16	<b>SCALE</b>
<b>DRAWN BY</b>	S.S.	06-20-16	1" = 1000'
<b>AS-DRILLED WELL LOCATION PLAT</b>			