


Well Name: FAIRMEADOW LAND CO 1

VERTICAL - ORIGINAL HOLE, 8/8/2016 8:01:35 AM

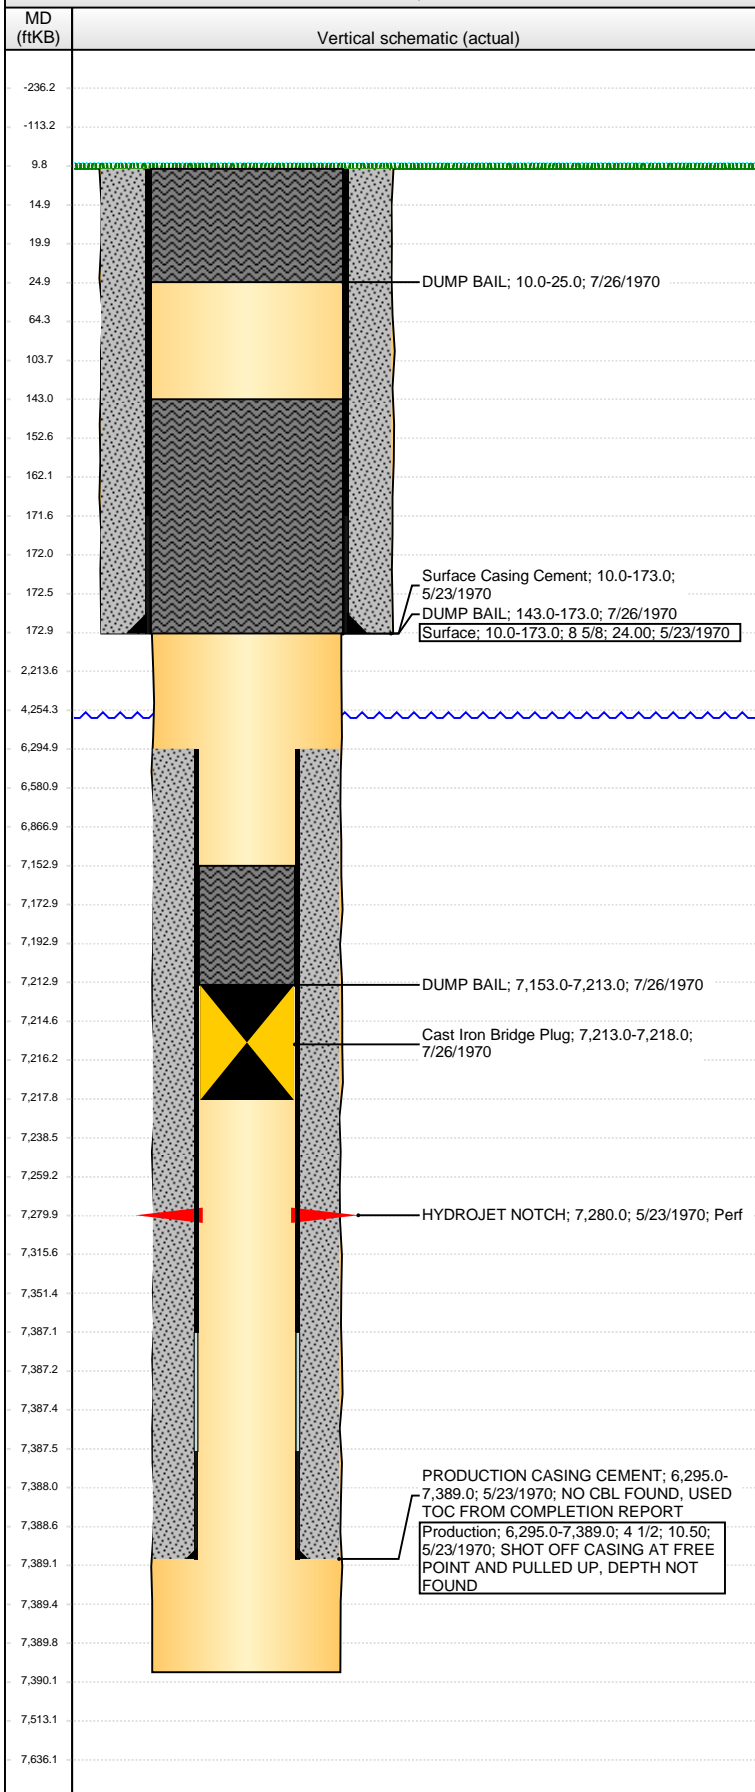

Well Header

API	Business Unit	District	Well Config
05-123-07163	DJ BASIN	15	VERTICAL
Original KB Elevation (ft)	KB - GL / MSL (ftKB)	Spud Date	P & A Date
4,646	10.00	5/11/1970	7/26/1970

Comment

VALIDATED USING STATE REPORTS

SHOT OFF CASING AT FREE POINT AND PULLED UP, DEPTH NOT FOUND

NO SURFACE CASING INFORMATION GIVEN - ESTIMATED BASED ON PA REPORT.

SURF PLUG DEPTHS ESTIMATED

Directions To Well

Congressional Location

Quarter 3	Quarter 4	Section	Township	Twnshp N/S Dir	Range	Range E/W Dir
		25	6	N	64	W

Bottom Hole Location

North-South Distance (ft)	From N or S Line	East-West Distance (ft)	From E or W Line

Plug Back Total Depths

Date	Depth (ftKB)	Method	Com

Wellbore Sections

Section Des	Size (in)	Act Top, MD (ftKB)	Act Btm, MD (ftKB)
SURFACE	12 1/4	10	173
PRODUCTION	7 7/8	173	7,390

Zone Statuses

Zone Name	Status Date	Status	Fluid Type	Job	Prod Method

Casing Strings

Surface, 173.0ftKB

Casing Description	Run Date	OD (in)	Wt/Len (l...)	Grade	Top, MD (ft...)	MD (ftKB)
Surface	5/23/1970	8 5/8	24.00		10.0	173.0

Production, 7,389.0ftKB

Casing Description	Run Date	OD (in)	Wt/Len (l...)	Grade	Top, MD (ft...)	MD (ftKB)
Production	5/23/1970	4 1/2	10.50		10.0	7,389.0

Cement

Description	Top Depth (ftKB)	Bottom Depth (ftKB)
PRODUCTION CASING CEMENT	6,295.0	7,389.0
Surface Casing Cement	10.0	173.0
DUMP BAIL	7,153.0	7,213.0
DUMP BAIL	143.0	173.0
DUMP BAIL	10.0	25.0

Tubing Strings

Tubing Description	Run Date	String...	ID (in)	Wt (lb/ft)	Grade	Len (ft)	Set De...

Perforation Data

Zone	Bnch/St g	Entered Shot Total	Top (ftKB)	Btm (ftKB)	Date
		1	7,280.00	7,280.00	5/23/1970

Other In Hole

Run Date	Des	OD (in)	Top (ftKB)	Btm (ftKB)
7/26/1970	Cast Iron Bridge Plug	4	7,213.0	7,218.0

Logs

Date	Type	Top, MD (ftKB)	Btm, MD (ftKB)
5/22/1970	COMPENSATED DENSITY	7,100.0	7,355.0
5/22/1970	INDUCTION	173.0	7,355.0