




EXPLORATION CO

Wellbore Schematic

Not to Scale

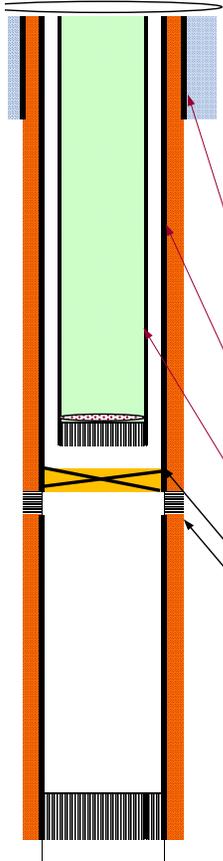

Well Name **WRD Fed 7-33**
 Diagram Date **16-Oct-15**
 Surface Location **NENE 2000' FNL, 2000' FEL, Sec 33, T2N, R97W.**
 Field **White River Dome**
 County **Rio Blanco County**
 State **Colorado**
 API No. **05-103-09964-00**
 Lease No. **C-45291**
 G.L. Elevation **5,931'**
 K.B. Elevation **5,944'**

TREE	
Tubing Hanger	
Tubing Head	
Casing Head	
Casing Hanger	

Tops of Formations:

Zone	Depth
Wasatch	303-1994

Casing 1 0-300' **7" OD, 20#, K-55**
 Cement w/ 85 sx to surface

Casing 2 0-2280' **4 1/2" OD, 9.5#, K-55**
 Cement w/ 310 sx to 450'

Tubing 1 EOT @ 1,278' **2 3/8" OD, 4.7#, J-55, 8rd**

CIBP 1310
Perforations 1363-1368 **10 Holes at 2 spf**

Shoe: 8119
TD: 8128

Date: 1/19/2015 **Stage:** Stage 1 **Treatment Desc: (All Slickwater Fracs)**
 Acidize perforations with 500 gallons of 15% HCl and 300 SCF of Nitrogen per bbl of fluid down 2 3/8" tubing