	LEASE / WELL:	SURVEY LOCATION:	WELL SKETCH:
	TPR #1		**Rev 8/11/2016**
OPERATOR:	COUNTY / STATE:	SURFACE LOCATION:	FIELD:
CPX Piceance Holdings LLC	**Garfield/CO**		

DIRECTIONAL DATA

KOP:	
MAX DEV:	
DEV @ PERFS:	
DEV @ PERFS:	
DEV @ PERFS:	

DRILLING / COMPLETION FLUID

DRILLING FLUID:	ppg -
DRILLING FLUID:	ppg -
DRILLING FLUID:	ppg -
COMPLETION FLUID:	ppg -
PACKER FLUID:	ppg -

TUBULAR DATA

Tubulars	Size	Weight	Grade	Thread	MD	TVD	TOL
DRIVE PIPE							
CONDUCTOR	16"	84#			87'		
SURFACE	9 5/8"	36#	J-55	8rd	1344'		
INTERMEDIATE	7"	26#	HCP-110	LTC	11620'		
PRODUCTION	5"	21.4#	HCP-110	ULTRA SF	15677'		
PROD LINER							
PROD LINER							
TUBING (Short String)							
TUBING (Long String)	2-3/8"	4.7	N-80	8rd	9,891		
COILED TUBING							

WELLHEAD DATA

TYPE	GE
WP	
TREE CAP — FLANGE:	
TREE CAP — THREAD:	
TUBING HANGER:	
BTM FLANGE:	
BPV PROFILE:	
ELEVATIONS: KB: **24'**	GROUND ELEVATION **9131'**

WELLBORE SKETCH

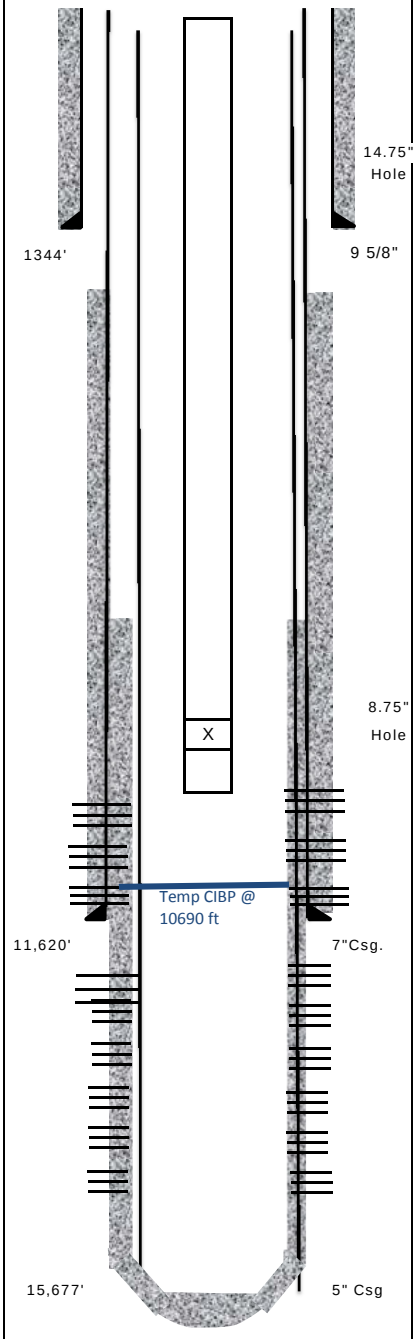

EQUIPMENT DESCRIPTION	O D	I D	LENGTH	DEPTH MD	INCL DEG	DEPTH TVD
Surface Casing						
9 5/8",36#, J-55 8rd				1344'		
Produciton Tbg				9,859	X-nipple	
2-3/8" , N-80, 4.7#, 8R				9,891		
X Nipple at **9859**						
EOT at **9891**						
Intermediate Casing				11,620'		
7",26#,HCP-110, LTC						
Perfs:						
10387' - 10533', 10102' - 10256', 9700' - 9927', 9157' - 9482', 8855' - 9089'	Williams Fork					
10708' - 10724'	Cameo Coal					
11307'-11338'	Cozzette					
11442' - 11525'	Corcoran					
12333'-12438', 12669'-12749', 13187'-13286', 13433'-13580', 13647'- 13796'	Mancos "A"					
13807'-14160'	Mancos "A/B"					
14255'-14492', 14514'-14799'	Mancos "B"					
14827'- 15054', 15105'-15352', 15415'-15570'	Niobrara					
Production Casing						
5",21.4#,HCP-110,Ultra SF csg				15,677'		

COMMENTS:

API # 05045169470000

Spud Date: 1/11/2013

PLUG BACK DEPTH:	
TOTAL WELL DEPTH:	**15,691**
PREPARED OR REVISED BY:	**DATE:**
RH	March 27, 2015