Lat40°, Inc. 6250 W. 10th Street, Unit 2, Greeley, CO 970-515-5294

WELL LOCATION CERTIFICATE

PAUL 27W-434

SECTION: 27
TOWNSHIP: 5N
RANGE: 67W
6TH. P.M.
WELD COUNTY, CO

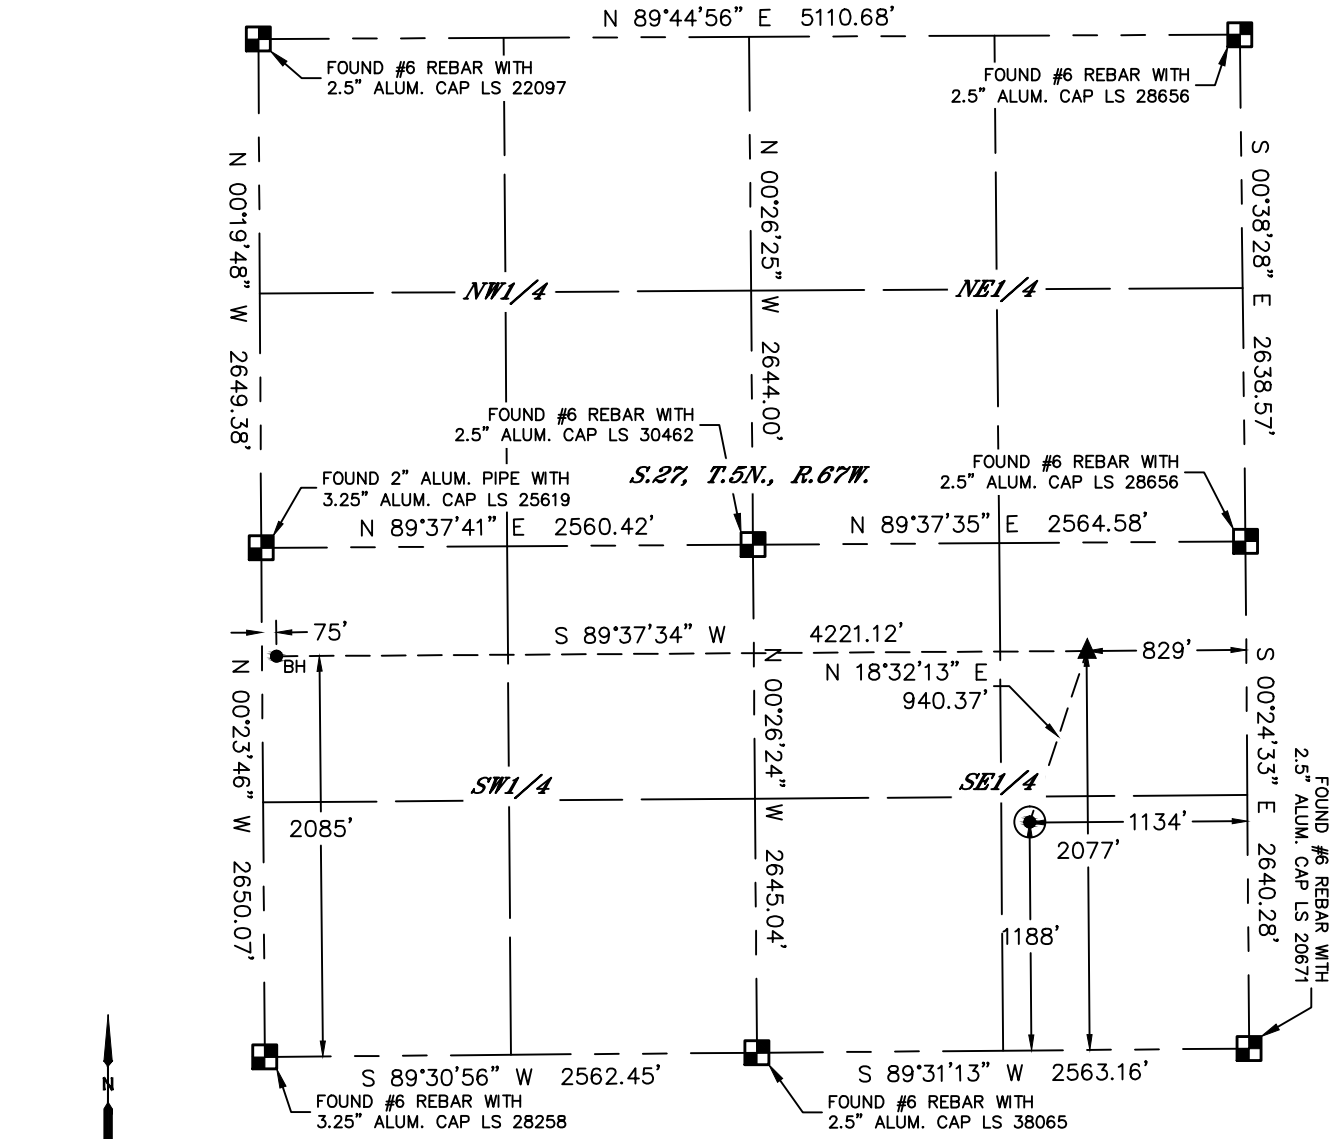

N

0 1000

1"=1000'

CLIENT: PDC ENERGY						LANDMAN: JEFF HINDMARSH			
INSTRUMENT OPERATOR: CASEY KOHOUT						SURVEY DATE: 2/16/2016		SURFACE USE: CROP LAND	
SHL FOOTAGE				SHL LAT°	SHL LONG°	SHL PDOP	SHL ELEV	SHL 1/4/1/4	SHL S-T-R
1188	FSL	1134	FEL	40.36669	-104.87385	1.9	4927	SESE	27-5-67

BHL FOOTAGE				BHL LAT°	BHL LONG°	BHL S-T-R	EP LAT°	EP LONG°	EP S-T-R
2085	FSL	75	FWL	40.36913	-104.88790	27-5-67	40.36913	-104.87276	27-5-67

NEAREST CULTURAL ITEMS	
BUILDING	±1460' SW
BUILDING UNIT	±1068' SE
HIGH OCCUPANCY BUILDING UNIT	5280'+
DESIGNATED OUTSIDE ACTIVITY AREA	5280'+
PUBLIC ROAD (HIGHWAY 257)	±1115' E
ABOVE GROUND UTILITY	±1038' SE
RAILROAD	±5086' SW
PROPERTY LINE	±148' W

NOTE:
1) Bearings shown are Grid Bearings of the Colorado State Plane Coordinate System, North Zone, North American Datum 1983. The lineal dimensions as contained herein are based upon the "U.S. Survey Foot."
2) Distances to section lines measured at 90 degrees from said section lines.
3) Ground elevations are based on an observed GPS elevation (NAVD 1988 DATUM).
4) Latitude and Longitude shown are (NAD 83 DATUM).
5) IMPROVEMENTS: See LOCATION DRAWING for all visible improvements within 500' of oil and gas location.
6) This map does not represent a boundary survey.

LEGEND

= ALIQUOT MONUMENT AS DESCRIBED
= CALCULATED POSITION
= SURFACE HOLE LOCATION (SHL)
= ENTRY POINT LOCATION (EP)
BH = BOTTOM HOLE LOCATION (BHL)
= EXISTING WELL
= ABANDONED WELL

COLORADO LICENSED THOMAS BRINKMAN BRIAN T. 38175 6/16/16 PROFESSIONAL LAND SURVEYOR

Brian T. Brinkman—On behalf of Lat40°, Inc.
Colorado Licensed Professional Land Surveyor No. 38175

DATE: 6/16/2016
PROJECT#: 2015134