




Black Hills Plateau Production, LLC A Black Hills Corporation Enterprise

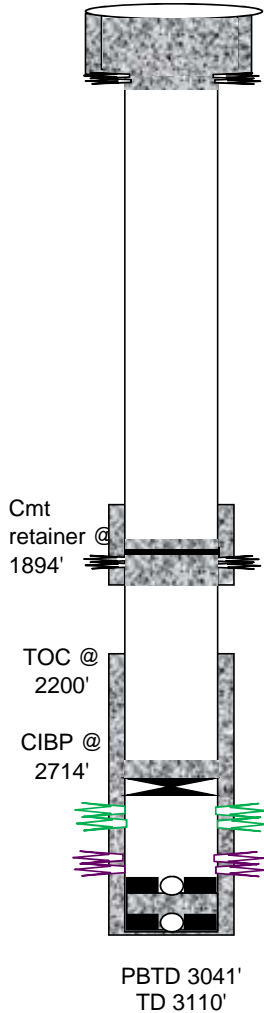

Float Collar @

Float Shoe @ 3110'

General Well Info			
Well Name:	Fetters 2-19	Field:	Plateau
Diagram Date:	8/18/2016	County:	Mesa
Srf Location:	NENE S19 T10S R96W	State:	Colorado
BLM #:	N/A	API #:	05-077-08137
GL Elev:	5471'	KB Elev:	5480'
Formation Tops			
Zone	Depth	Zone	Depth
Rollins	2442'		
Cozzette	2782'		
Corcoran	2936'		

Srf Csg 12 1/4" hole, 8-5/8" 24# K55 @ 262'

Srf Cmt 150sx cmt TOC @ surface

Prod Csg 7 7/8" hole, 5-1/2" 15.5# K55 @ 3109'

Prod Cmt 125 sx Thix cmt, TOC est. 2200'

Prod Tbg 90 jts, 2-3/8" eue 8rd, 1.81" 'F' nipple, 1 jt, NC
EOT @ 2845'

COZZ (9/4/96) 2789'-2792', 2826'-2832', 2839'-2850' (4 jsfp, 80 total holes, 0.4", 90 deg phsg, 23 gram)

Frac (9/5/96) 19387 gal 2% KCl wtr, 100600# 20/40 mesh sd, 1015000 scf N2

CRCRN (10/22/79) 2940'-2950', 2954'-2956', 2968'-2972', (36 holes total)

Frac (10/22/79) Foam frac w/ 9000# sd, 30000 gals gel KCl water, 30 tons CO2

CRCRN (8/22/96) 2997'-3028', 3046'-3054' (4 spf, 156 holes, 0.38")

Frac (8/22/96) 33665 gal gel wtr, 94500# 20/40 white sd, screened out

Actual P&A 8/12/16

Run CBL. TOC @ 2200'

Set 5 1/2" CIBP @ +/- 2714' Dump bail 2 sx cmt on top of plug.

Perf 4 circ holes @ 1950' (50' above top of aquifer)

Set cmt retainer @ 1894' (50' above top perf). Pump 40 sx Class CI cmt below retainer. Dump 10 sx cmt on top.

Perf 4 circ holes @ 400'. Pump 100 sx Class C. Circ cmt to surf. Top off w/ 25 sx.

Dig out wellhead. Cut off 8 5/8" and 5 1/2" csg 4' below ground level. Install dry hole marker as per COGCC and landowner.