Whiting Oil & Gas Corp
1700 Broadway, Suite 2300
Denver, CO 80290
(303) 837-1661

RAZOR 12F-0104B

Well Name	API Number	County
RAZOR 12F-0104B	051233872300	Weld

Section	Township	Township N/S Dir	Range	Range E/W Dir	Meridian	Quarter 1	Quarter 2
12	10	N	58	W		SE	NW

Lateral/Horizontal - Original Hole, 8/24/2016 2:48:45 PM

Vertical schematic (actual)

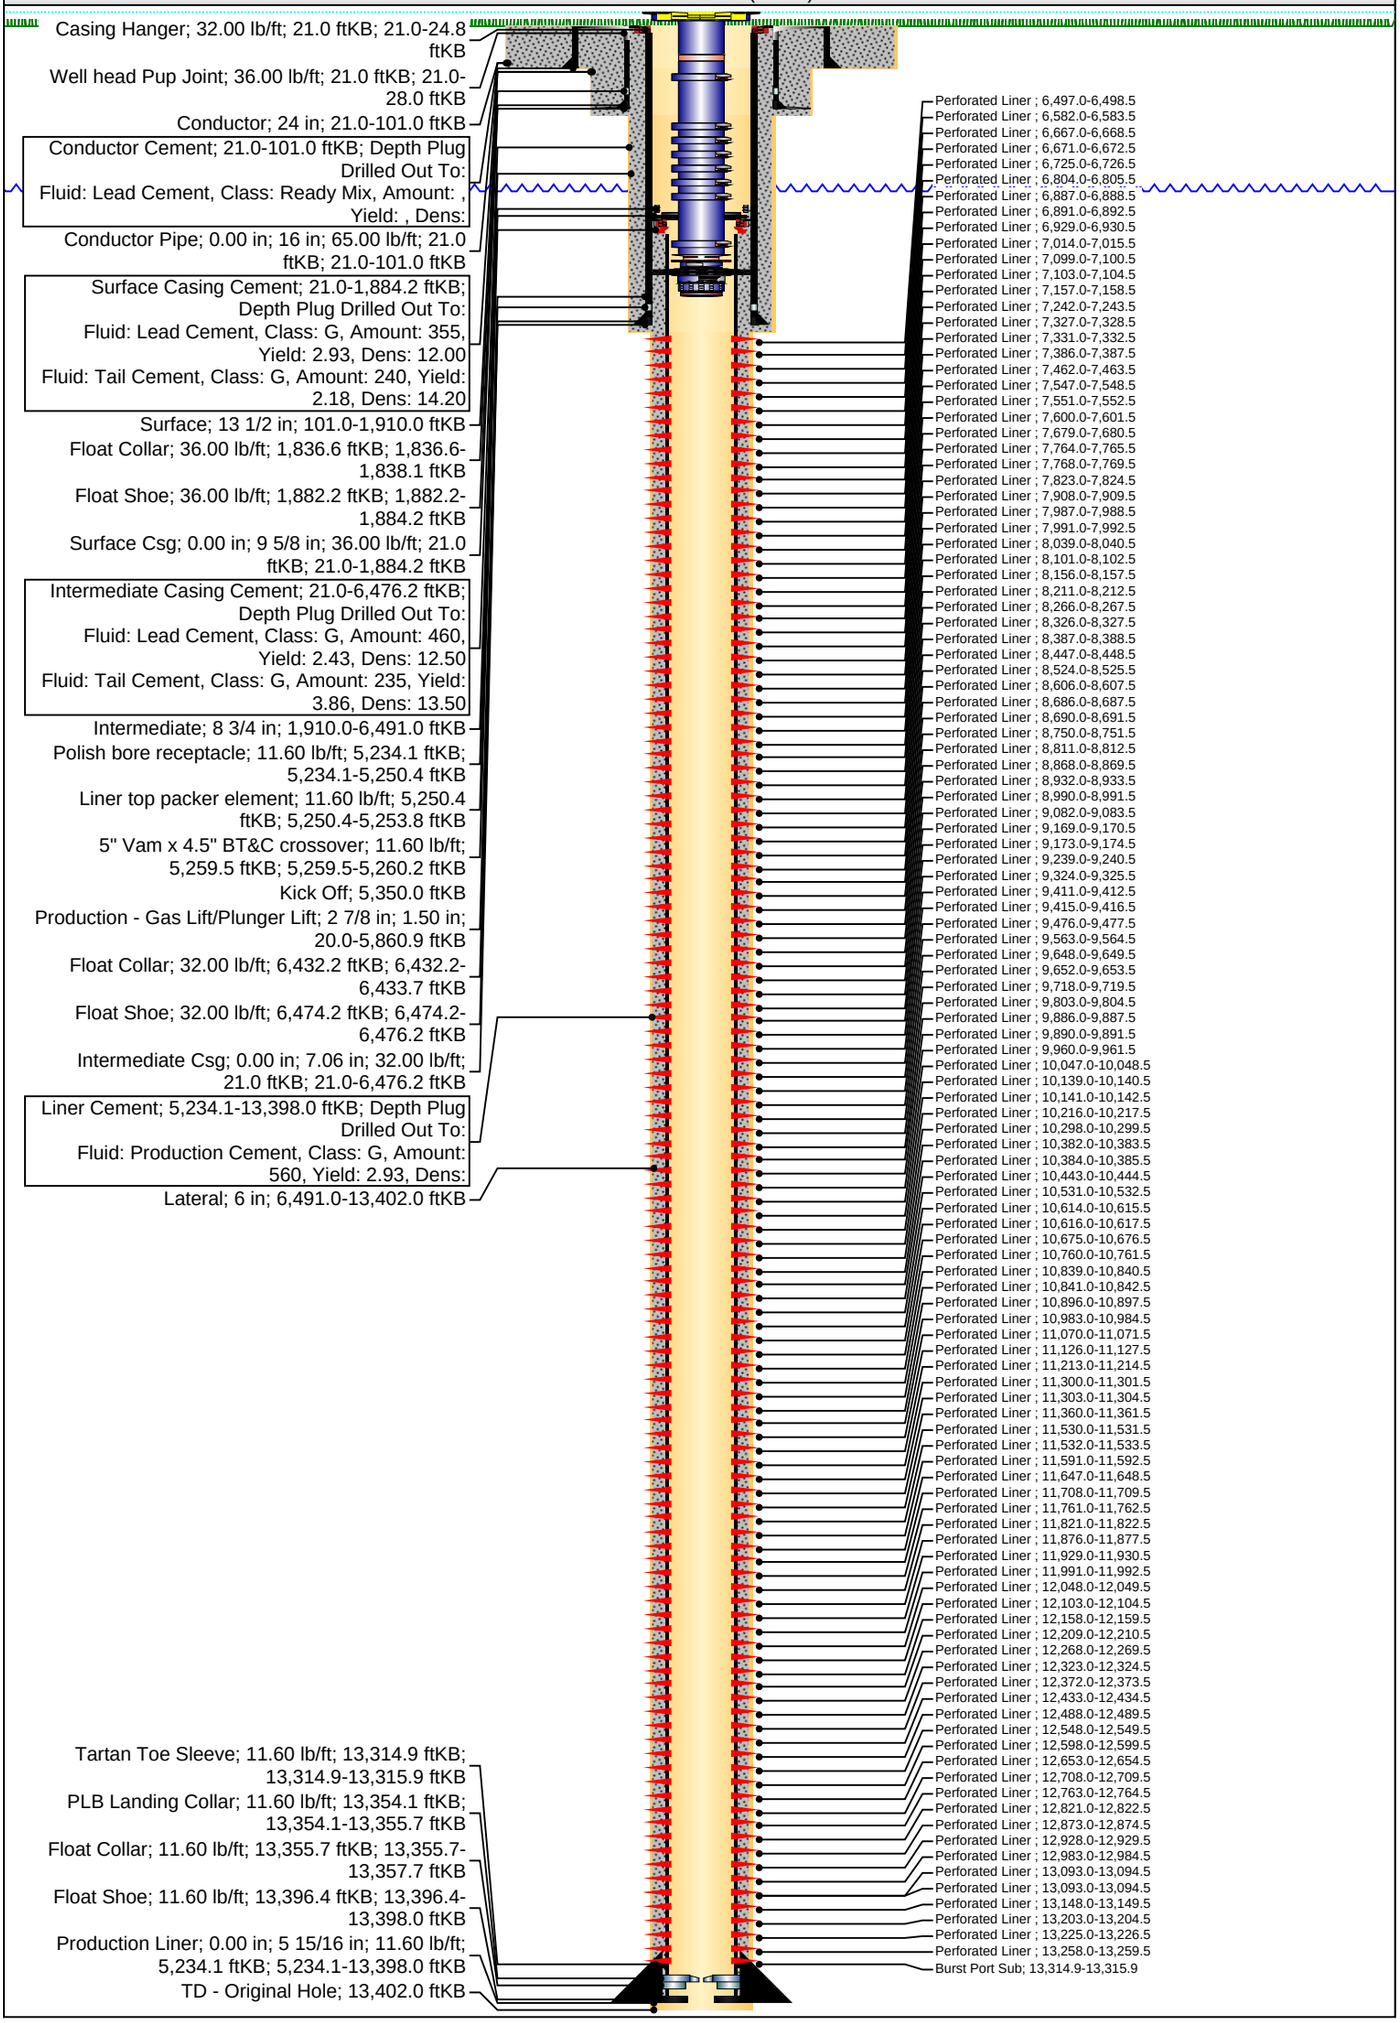

Report Date: 8/24/2016