


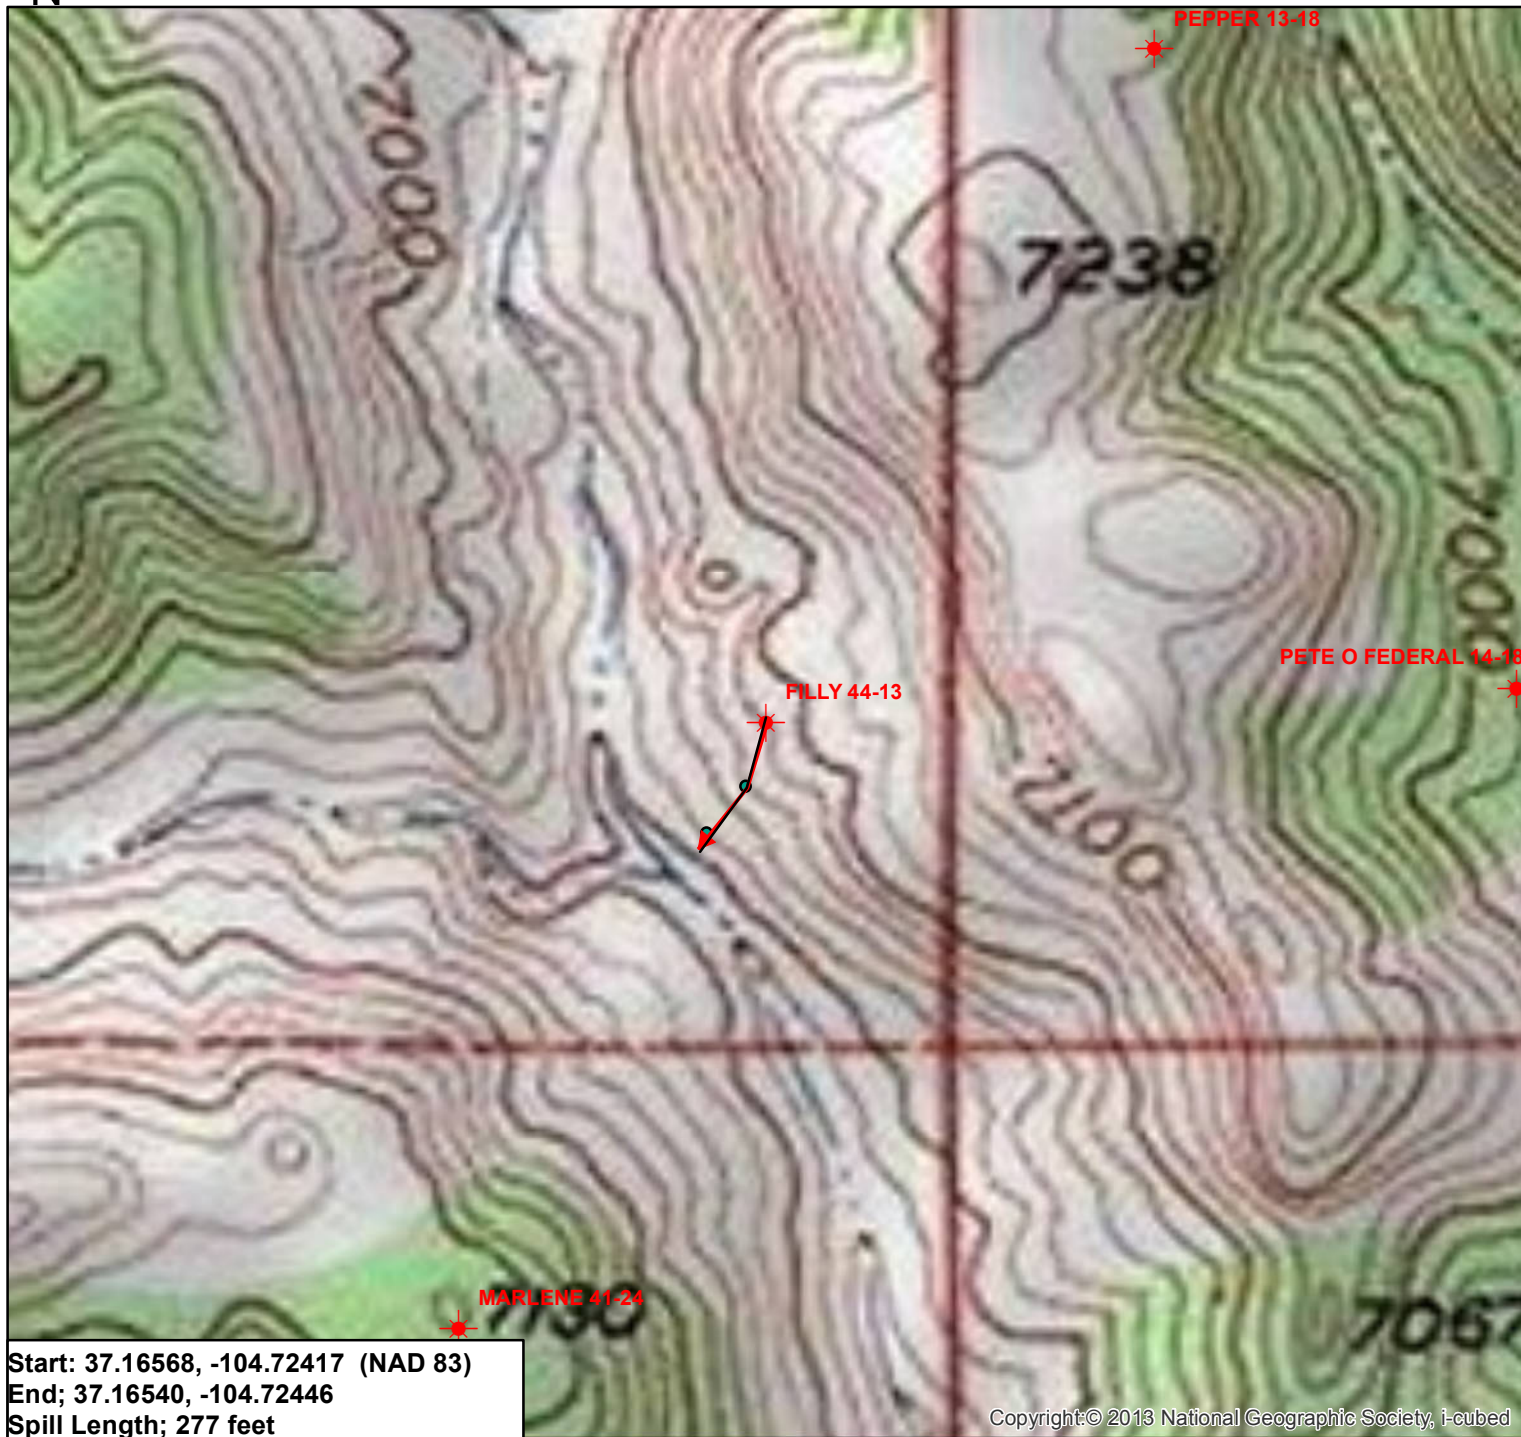

# Topographical Spill Map

Filly 44-13 spill map



Permitted Well



Spill on location

0 250 500 750 1,000 Feet

1:5,000