
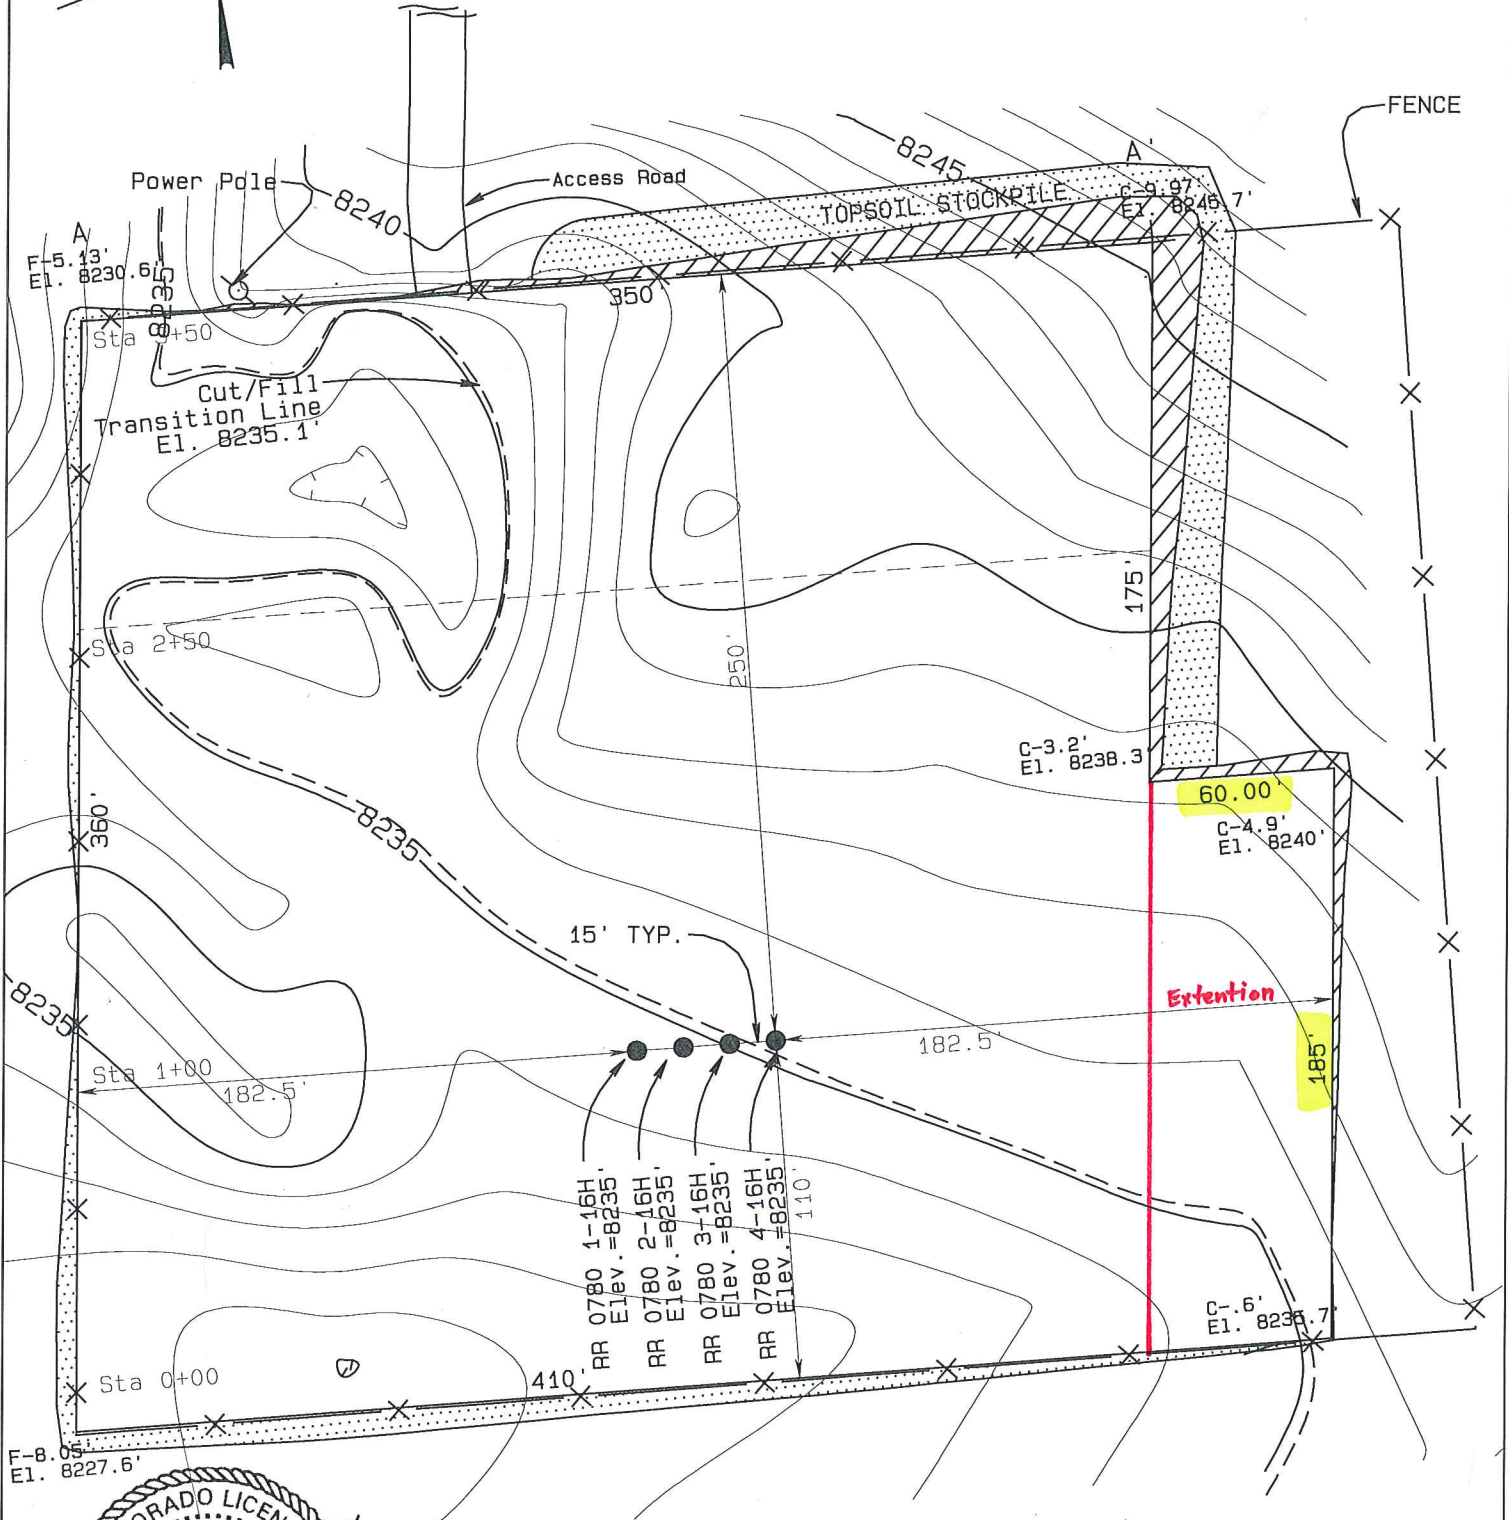


# SandRidge Exploration & Production, LLC


## CONSTRUCTION LAYOUT

EVANS 0780 21 PAD

NW1/4NE1/4 of SECTION 21, T7N, 80W, 6th PM

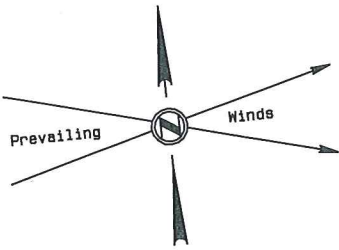

SandRidge Exploration & Production, LLC  
CONSTRUCTION LAYOUT CROSS SECTION  
EVANS 0780 21 PAD  
NW1/4NE1/4 of SECTION 21, T7N, 80W, 6th PM

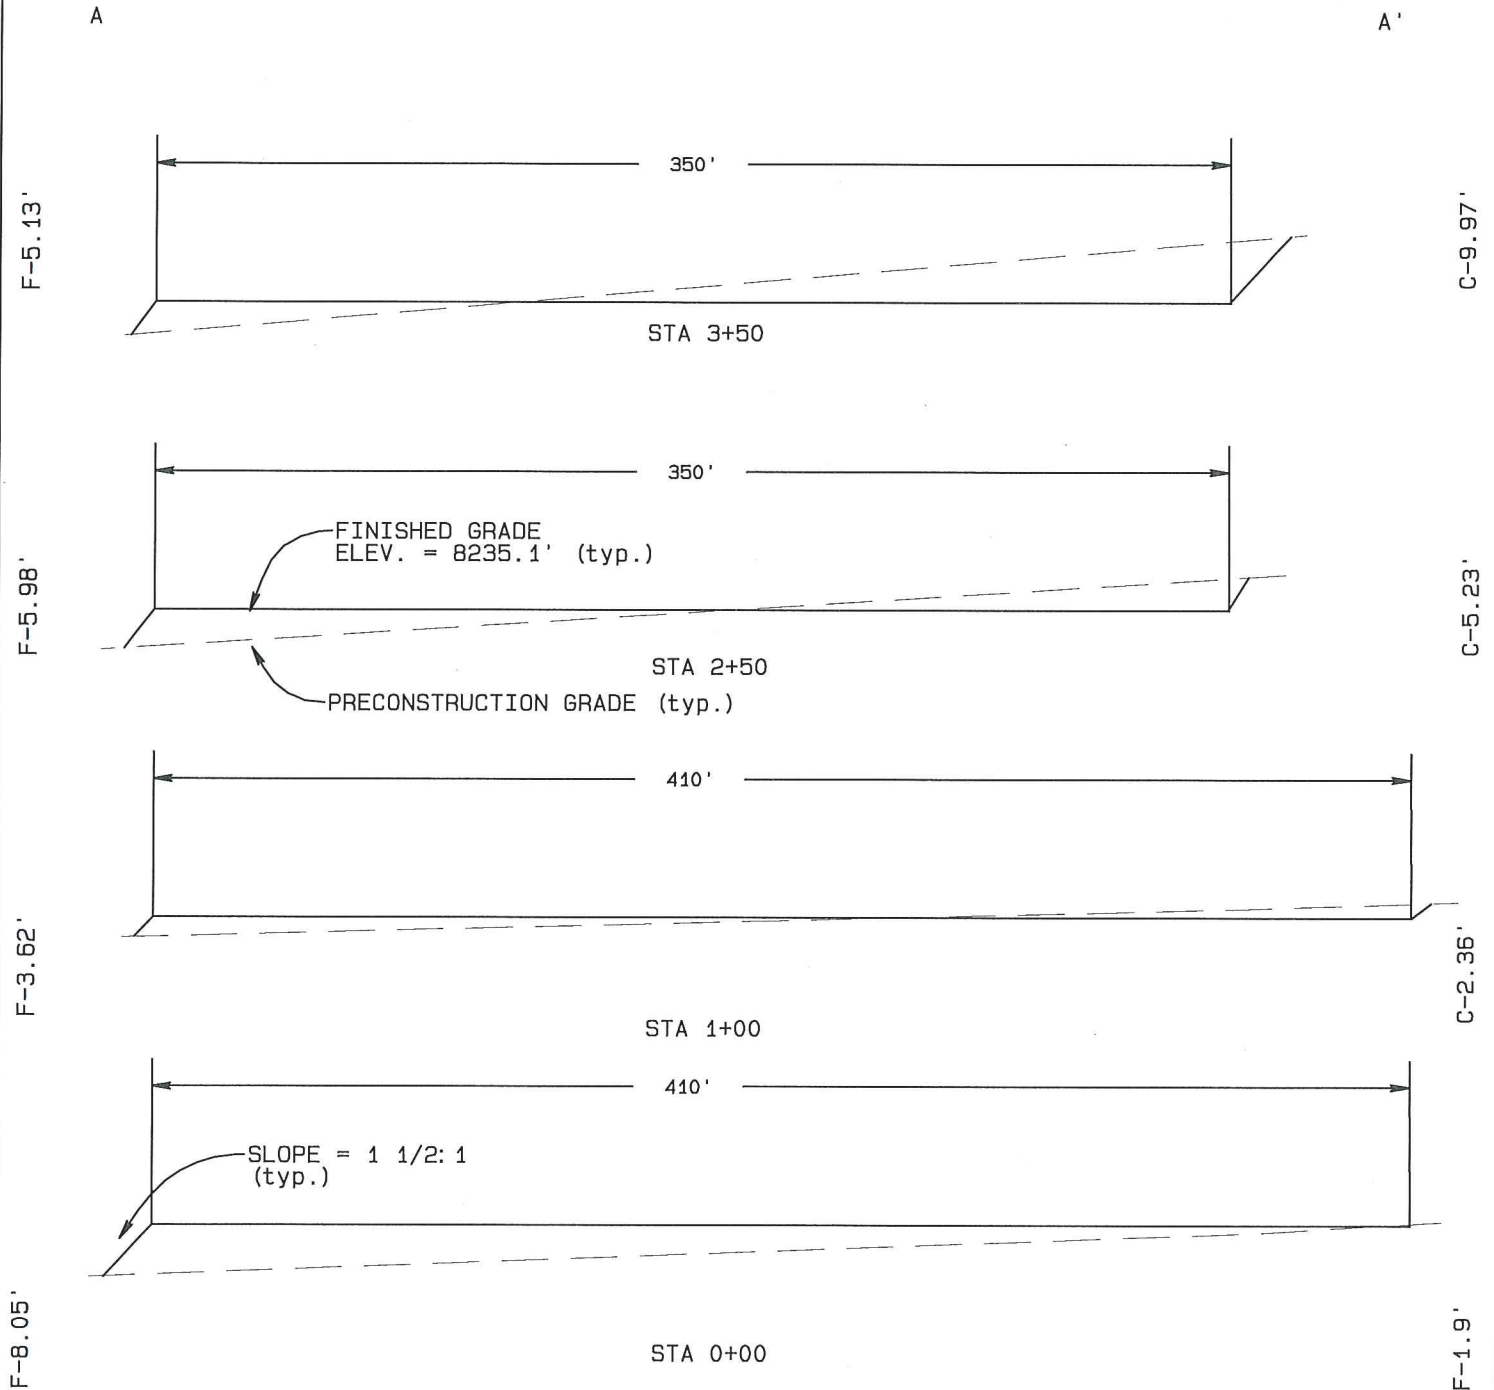

Vertical Exag = 2 Times  
Final Pad Grade = 8235.1'

