


Wellbore Schematic Input Report

Well Name: ALM USX E11-11

VERTICAL - ORIGINAL HOLE, 8/30/2016 10:48:22 AM

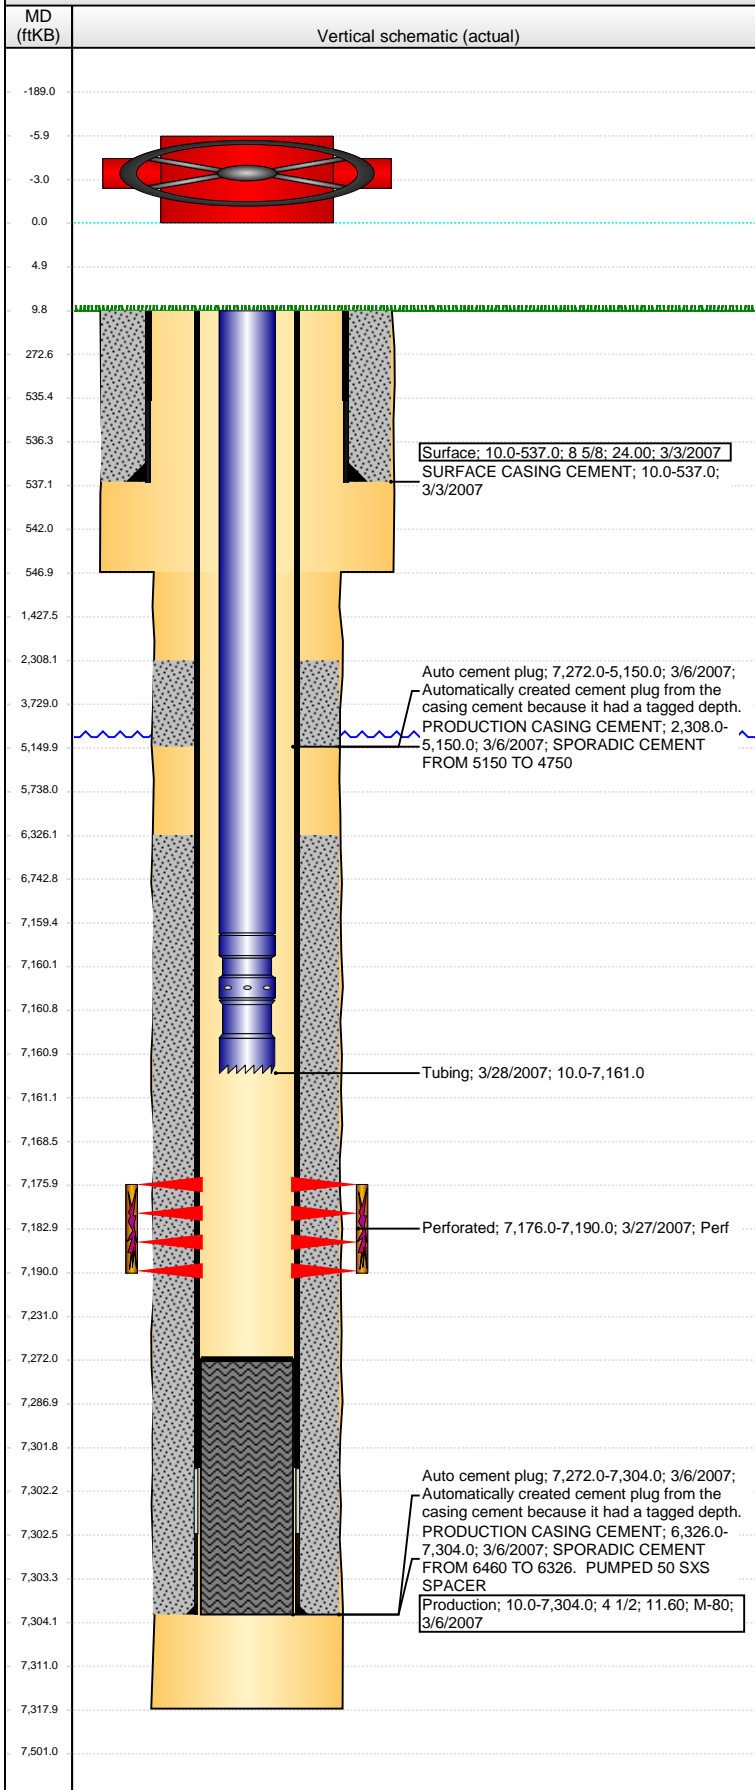

Well Header

API	Business Unit	District	Well Config
05-123-24483	DJ BASIN	15	VERTICAL
Original KB Elevation (ft)	KB - GL / MSL (ftKB)	Spud Date	P & A Date
4,802	10.00	3/2/2007	

Comment
FIRST DATE OF PRODUCTION DISCREPANY - COMPLETION REPORT'S DATE IS 4/30/07 - NOBLE REPORT'S DATE IS 4/9/07

Directions To Well

Congressional Location

Quarter 3	Quarter 4	Section	Township	TwNS Dir	Range	Range E/W Dir
NE	SW	11	6	N	65	W

Bottom Hole Location

North-South Distance (ft)	From N or S Line	East-West Distance (ft)	From E or W Line

Plug Back Total Depths

Date	Depth (ftKB)	Method	Com
3/6/2007	7,288.0	CASING TALLY	FLOAT COLLAR ON CASING TALLY
3/12/2007	7,272.0	CASED HOLE LOG	DEPTH LOGGER ON CBL

Wellbore Sections

Section Des	Size (in)	Act Top, MD (ftKB)	Act Btm, MD (ftKB)
SURFACE	12 1/4	10	547
PRODUCTION	7 7/8	547	7,318

Zone Statuses

Zone Name	Status Date	Status	Fluid Type	Job	Prod Method
CODELL		PR			

Casing Strings

Surface, 537.0ftKB	Run Date	OD (in)	Wt/Len (l...)	Grade	Top, MD (ft...)	MD (ftKB)
Casing Description	3/3/2007	8 5/8	24.00		10.0	537.0
Surface						

Production, 7,304.0ftKB

Run Date	OD (in)	Wt/Len (l...)	Grade	Top, MD (ft...)	MD (ftKB)
3/6/2007	4 1/2	11.60	M-80	10.0	7,304.0

Cement

Description	Top Depth (ftKB)	Bottom Depth (ftKB)
SURFACE CASING CEMENT	10.0	537.0
Description	Top Depth (ftKB)	Bottom Depth (ftKB)
PRODUCTION CASING CEMENT	2,308.0	5,150.0
Description	Top Depth (ftKB)	Bottom Depth (ftKB)
PRODUCTION CASING CEMENT	6,326.0	7,304.0

Tubing Strings

Tubing Description	Run Date	String...	ID (in)	Wt (lb/ft)	Grade	Len (ft)	Set De...
Tubing	3/28/2007	2 3/8	1.995	4.70	J-55	7,151.00	

Tubing Components

Item Des	OD (in)	Wt (lb/ft)	Grade	Jts	Len (ft)	Btm (ftKB)	Btm (TVD) (ftKB)
EUE 8rd Tubing	2 3/8	4.70	J-55	231	7,149.60	7,159.6	
Seal Nipple	2 3/8			1	1.00	7,160.6	
Notched collar	2 3/8			1	0.40	7,161.0	

Perforation Data

Zone	Bnch/St g	Entered Shot Total	Top (ftKB)	Btm (ftKB)	Date
CODELL, ORIGINAL HOLE		56	7,176.00	7,190.00	3/27/2007

Stimulations & Treatments

Date	Zone	Primary Job Type
4/4/2007	CODELL, ORIGINAL HOLE	DRILLING/COMPLETION - ORIGINAL
Technical Result	Tech Result Details	Tech Result Note

Comment

Other In Hole

Run Date	Des	OD (in)	Top (ftKB)	Btm (ftKB)

Logs

Date	Type	Top, MD (ftKB)	Btm, MD (ftKB)
3/6/2007	COMPENSATED DENSITY	2,500.0	7,295.0
3/6/2007	INDUCTION	537.0	7,315.0
3/12/2007	CBL/CCL/GR	2,100.0	7,269.0