


WELLBORE DIAGRAM: Current configuration

Company: Chaparral Resources, Inc. **API:** 05-001-07215
Lease: _____ **Well No.:** AMEND #1 **Field:** WATTENBERG
Location: SESE, 30, 1S, 66 W, 6TH PM **County:** ADAMS **State:** COLORADO

WELLHEAD:

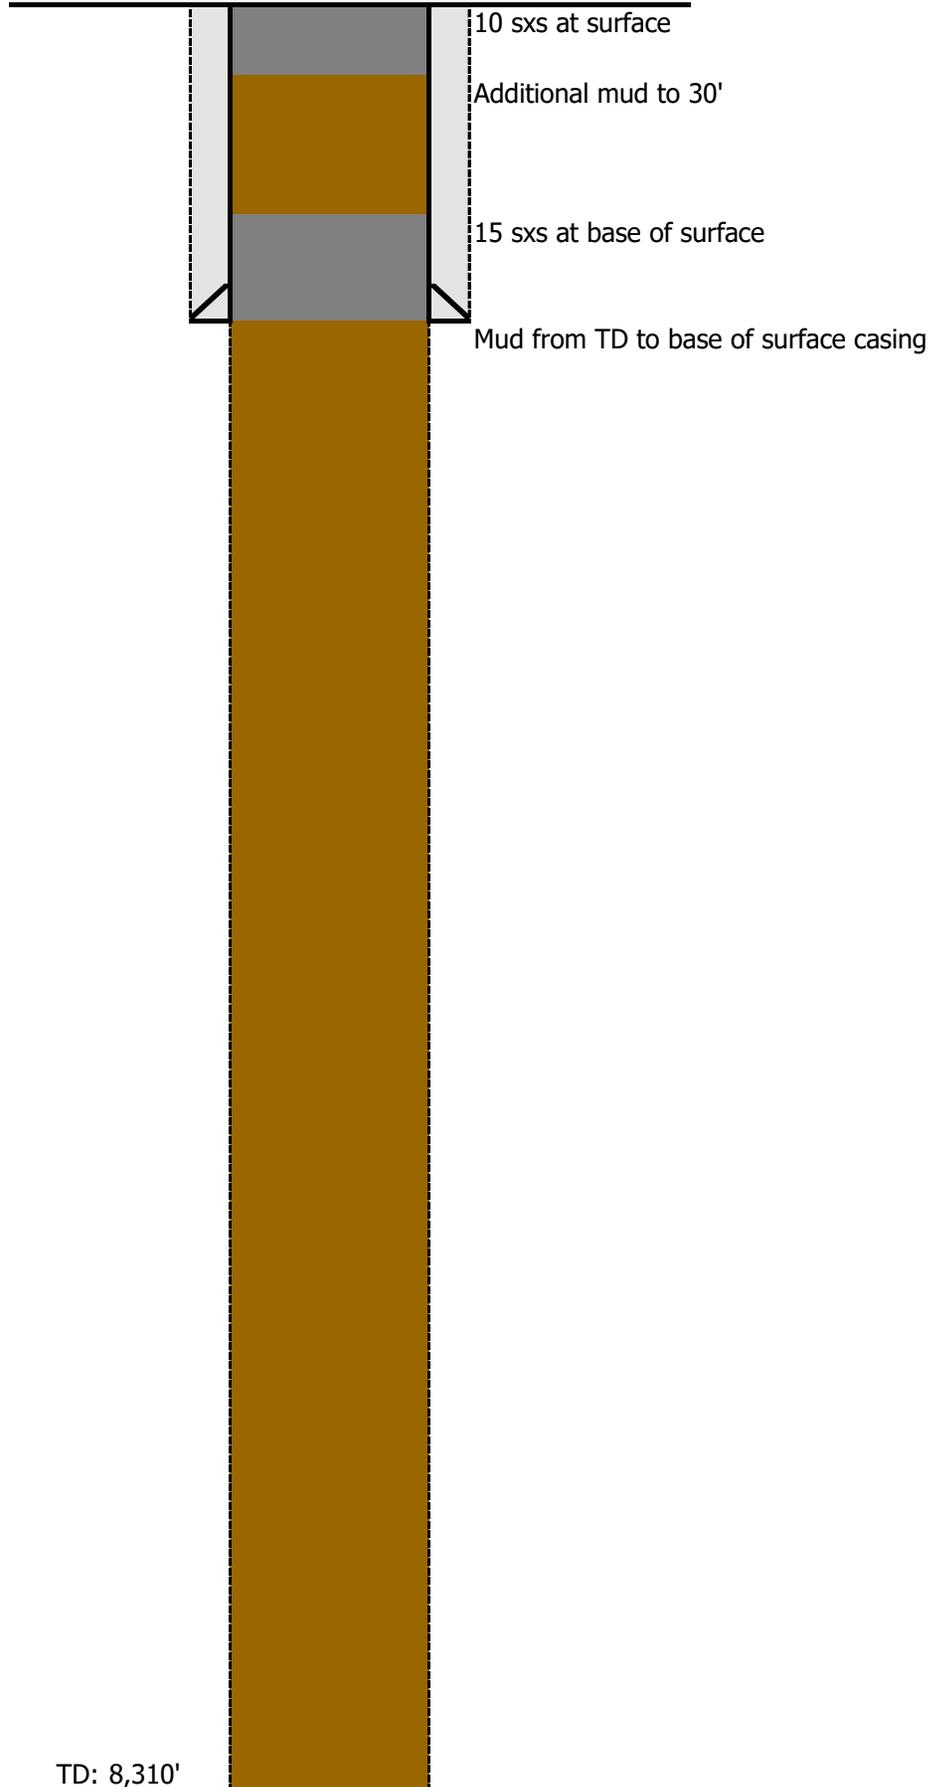

Surface Casing

Size: 8-5/8"
Wght: 23#
Type:
Depth: 210'
Csg ID:
Csg Drift:
TOC: SURFACE
Hole Size: 12-1/4"

Open Hole

Size: 7-7/8"
Wght:
Type:
Depth: 8310'
Csg ID:
Csg Drift:
TOC:
Hole Size: 7-7/8"

Updated:

By: Aron Rascon

TD: 8,310'