


**TEP Rocky Mountain LLC  
 YOUBERG RU 23-7  
 Rulison Field  
 Section 7 T 7S-R93W**

**Formation Tops  
 (Measured Depths)**

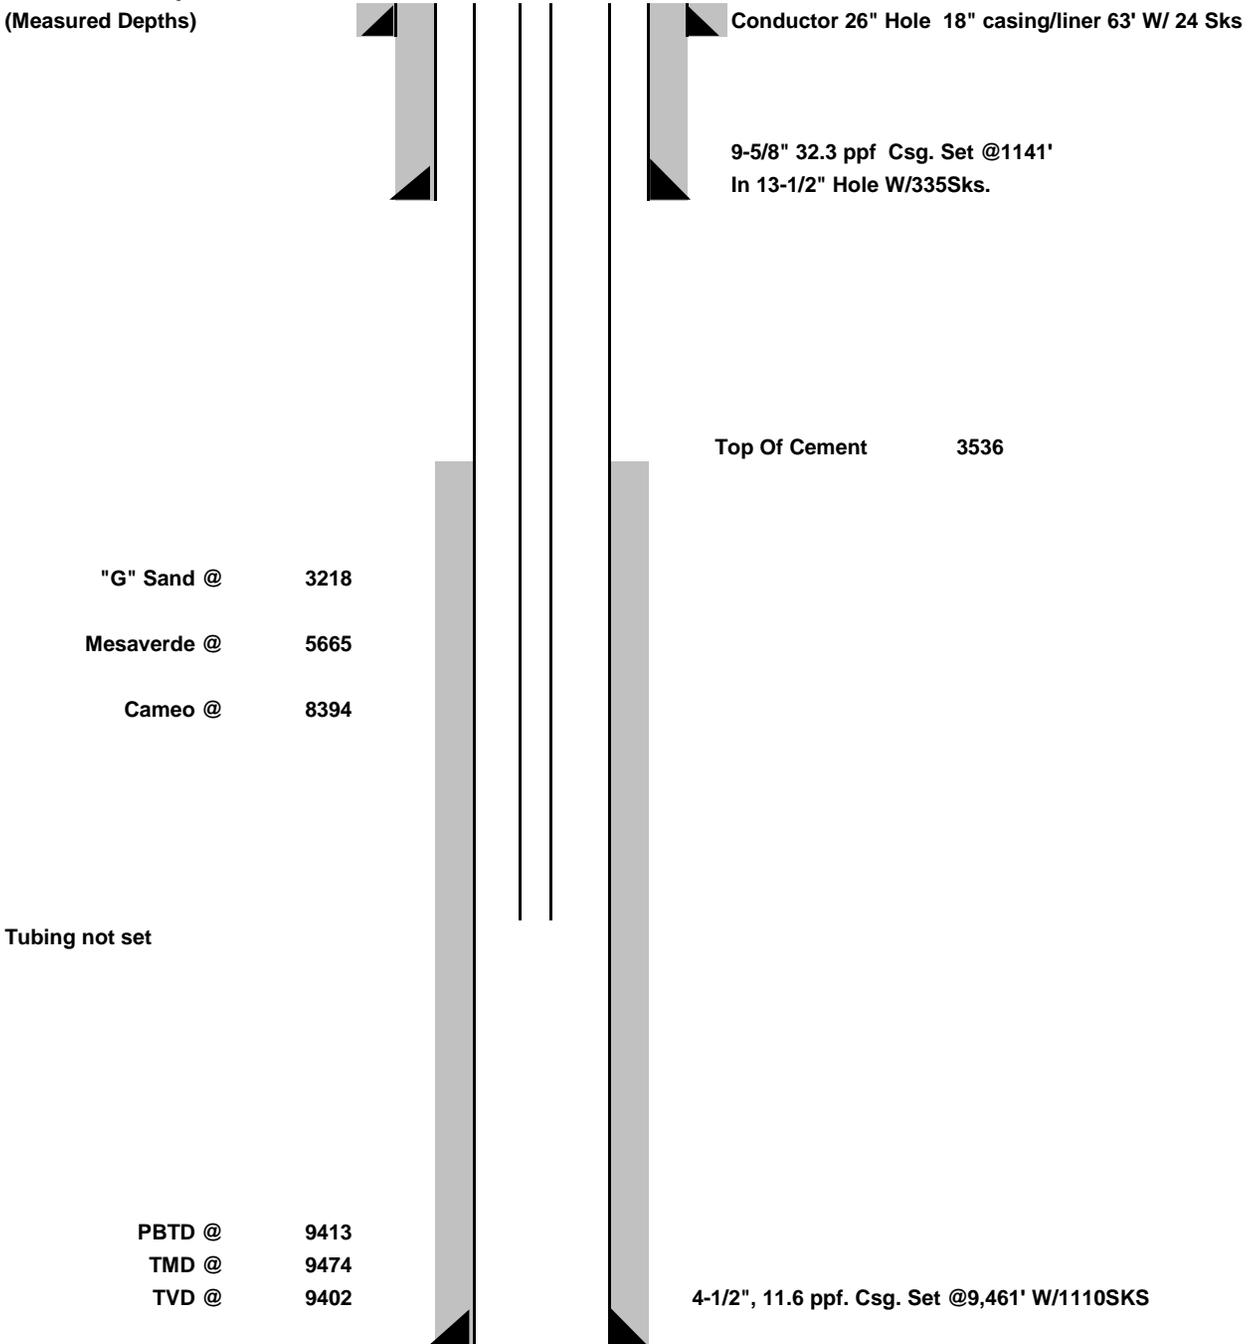

Tubing not set